



Known for excellence.  
Built on trust.

GEOTECHNICAL  
ENVIRONMENTAL  
ECOLOGICAL  
WATER  
CONSTRUCTION  
MANAGEMENT

GZA GeoEnvironmental of NY  
300 Pearl Street  
Suite 700  
Buffalo, NY 14202  
T: 716.685.2300  
F: 716.248.1472  
www.gza.com



October 7, 2022  
File: 21.0056984.00

Mr. George Streit  
[George.streit@nrgenergy.com](mailto:George.streit@nrgenergy.com)  
Dunkirk Power LLC  
106 Point Drive North  
Dunkirk, NY 14048

Re: CCR Landfill 2022 Annual Inspection  
Dunkirk Generating Station  
Van Buren Road  
Pomfret, New York

Dear Mr. Streit:

GZA GeoEnvironmental of New York (GZA) presents this 2022 Annual Landfill Inspection report to Dunkirk Power LLC (Dunkirk) for the existing coal combustion residuals (CCR) landfill units at the Dunkirk Generating Station landfill located in Pomfret, New York (Site). This annual inspection is required by the United States Environmental Protection Agencies (USEPA) Hazardous and Solid Waste Management System; Disposal of Coal Combustion Residuals from Electric Utilities; Final Rule, as presented in the Federal Register Volume 80 No 74 dated April 17, 2015. In accordance with the CCR Rule (40 CFR 257.84), owners/operators of CCR landfill units are required to be inspected on a periodic basis by a qualified professional engineer to check the design, construction, operation and maintenance of the CCR unit, consistent with recognized and generally accepted good engineering standards.

### Document Review

The required periodic inspections presented in the CCR Rule are for open and active landfills and not required for closed or inactive landfills. As such, the ash waste cells for the Site that are considered to be active are identified as Phase 2, Cells A and B-1. We note that these active portions of the landfill have a temporary cover system consisting of an approximate 12-inches of vegetated soil covering the previously exposed CCR waste. As a result, contact water (i.e., stormwater runoff over exposed CCR waste) runoff is not generated, rather stormwater runoff is considered clean.

The Site landfill cells identified as Phase 1, Cells A and B (excluding a small portion of the northern Phase I Cells A and B) and the eastern portion of Phase 2, Cell A are considered closed and are not included with this annual inspection report. The limits



of the active cells requiring this annual inspection report are shown on the attached figure prepared by Wendel for the 2021 fill progression survey (see **Figure 1**).

A constructed landfill cell designated as Phase 2, Cell B-2 (adjacent to Phase 2, Cell B-1 on the west) has never received waste ash and there are currently no future plans for this cell to receive coal ash waste, although accumulated stormwater in this cell does discharge to the active leachate collection system.

The Dunkirk Power landfill is currently permitted (ID#9-0658-00021/00008) with the New York State Department of Environmental Conservation (NYSDEC) to accept residual coal ash waste generated from the Dunkirk Power facility. This permit was to expire on May 22, 2021 and is currently undergoing the permit renewal process with NYSDEC to extend the Site permit for an additional ten-year period. A review of the 2021 (most recent) fill progression assessment for the Phase 2 Cells A and B-1 indicates the following information.

Phase 2 Landfill Cell	Ash/Material Received 2021 (cy)	Current Ash Volume (cy)	Volume Remaining (cy)
Cell A (western extent)	0	721,070	26,952
Cell B*	0	227,506	536,403
Totals for A & B-1	0	948,576	563,355

cy = cubic yards

\*Reported volume remaining in Cell B includes potential volume of Cell B-1 and B-2

The 2022 weekly landfill inspection forms prepared by Dunkirk Power personnel did not identify any concerns or complaints related to the operation and/or maintenance of the active ash landfill cells as these cells have had a temporary cover of vegetated topsoil.

**Site Observations**

GZA visited the Site on September 29, 2022 to make observations of the active landfill cell areas. During our visit, the landfill Cell A (area west of the upper intermediate berm) and Cell B-1 were observed covered with a temporary vegetated cover soil over the previously graded ash waste. Access to the top of the active landfill areas was made via an access road between Phase 1 and Phase 2 landfills. The access road was observed in good condition with little to no evidence of erosion or instability. Observations of the vegetated side slopes and top areas of the active cells identified no areas of actual or potential structural weaknesses and no exposed ash waste was observed. Evidence of recent grass mowing activities on the observed landfills was apparent.

Overall, the temporarily covered areas of the active landfill cells appeared to be similar to the previous year’s inspection observations and were graded in general accordance with the proposed design configurations. The side slopes and other areas were observed in good condition with no evidence of actual, or potential for, structural instability or erosion. Similar to the most recent inspection made in 2021, this inspection identified no areas of concern or areas evidencing structural instability. In general,







**NRG ENERGY**  
 108 POINT DRIVE, NORTH  
 DUNKIRK, NEW YORK 14051

**DUNKIRK POWER, LLC**

**ENGINEERING SERVICES**

**ANNUAL FILL PROGRESSION SURVEY FOR THE DUNKIRK LANDFILL**

**RECORD DRAWING**



Centerpoint Corporate Park  
 375 Essjay Road, Suite 200  
 Williamsville, NY 14221  
 www.wendelcompanies.com  
 p:716.668.6788 f:716.625.8825

Wendel WQ Architects, Engineering, Surveying and  
 Landscape Architects, P.C.



THIS DOCUMENT AND THE DATA HEREIN INCORPORATED HERETO AS A PART OF PROFESSIONAL SERVICES IS THE PROPERTY OF WENDEL WQ ARCHITECTS, ENGINEERING, SURVEYING AND LANDSCAPE ARCHITECTS, P.C. AND IS NOT TO BE REPRODUCED OR TRANSMITTED IN ANY FORM OR BY ANY MEANS, ELECTRONIC OR MECHANICAL, INCLUDING PHOTOCOPYING, RECORDING, OR BY ANY INFORMATION STORAGE AND RETRIEVAL SYSTEM, WITHOUT THE WRITTEN PERMISSION OF WENDEL WQ ARCHITECTS, ENGINEERING, SURVEYING AND LANDSCAPE ARCHITECTS, P.C.


NO.	REVISIONS	DATE

**DUNKIRK**

**2021 FILL PROGRESSION SURVEY**

**SITE PLAN**

DATE: 11-02-2021  
 SCALE: 1"=100'  
 DWN: NPL    CHK: RNJ  
 PROJ. NO.: 419425  
 DWG. NO.:

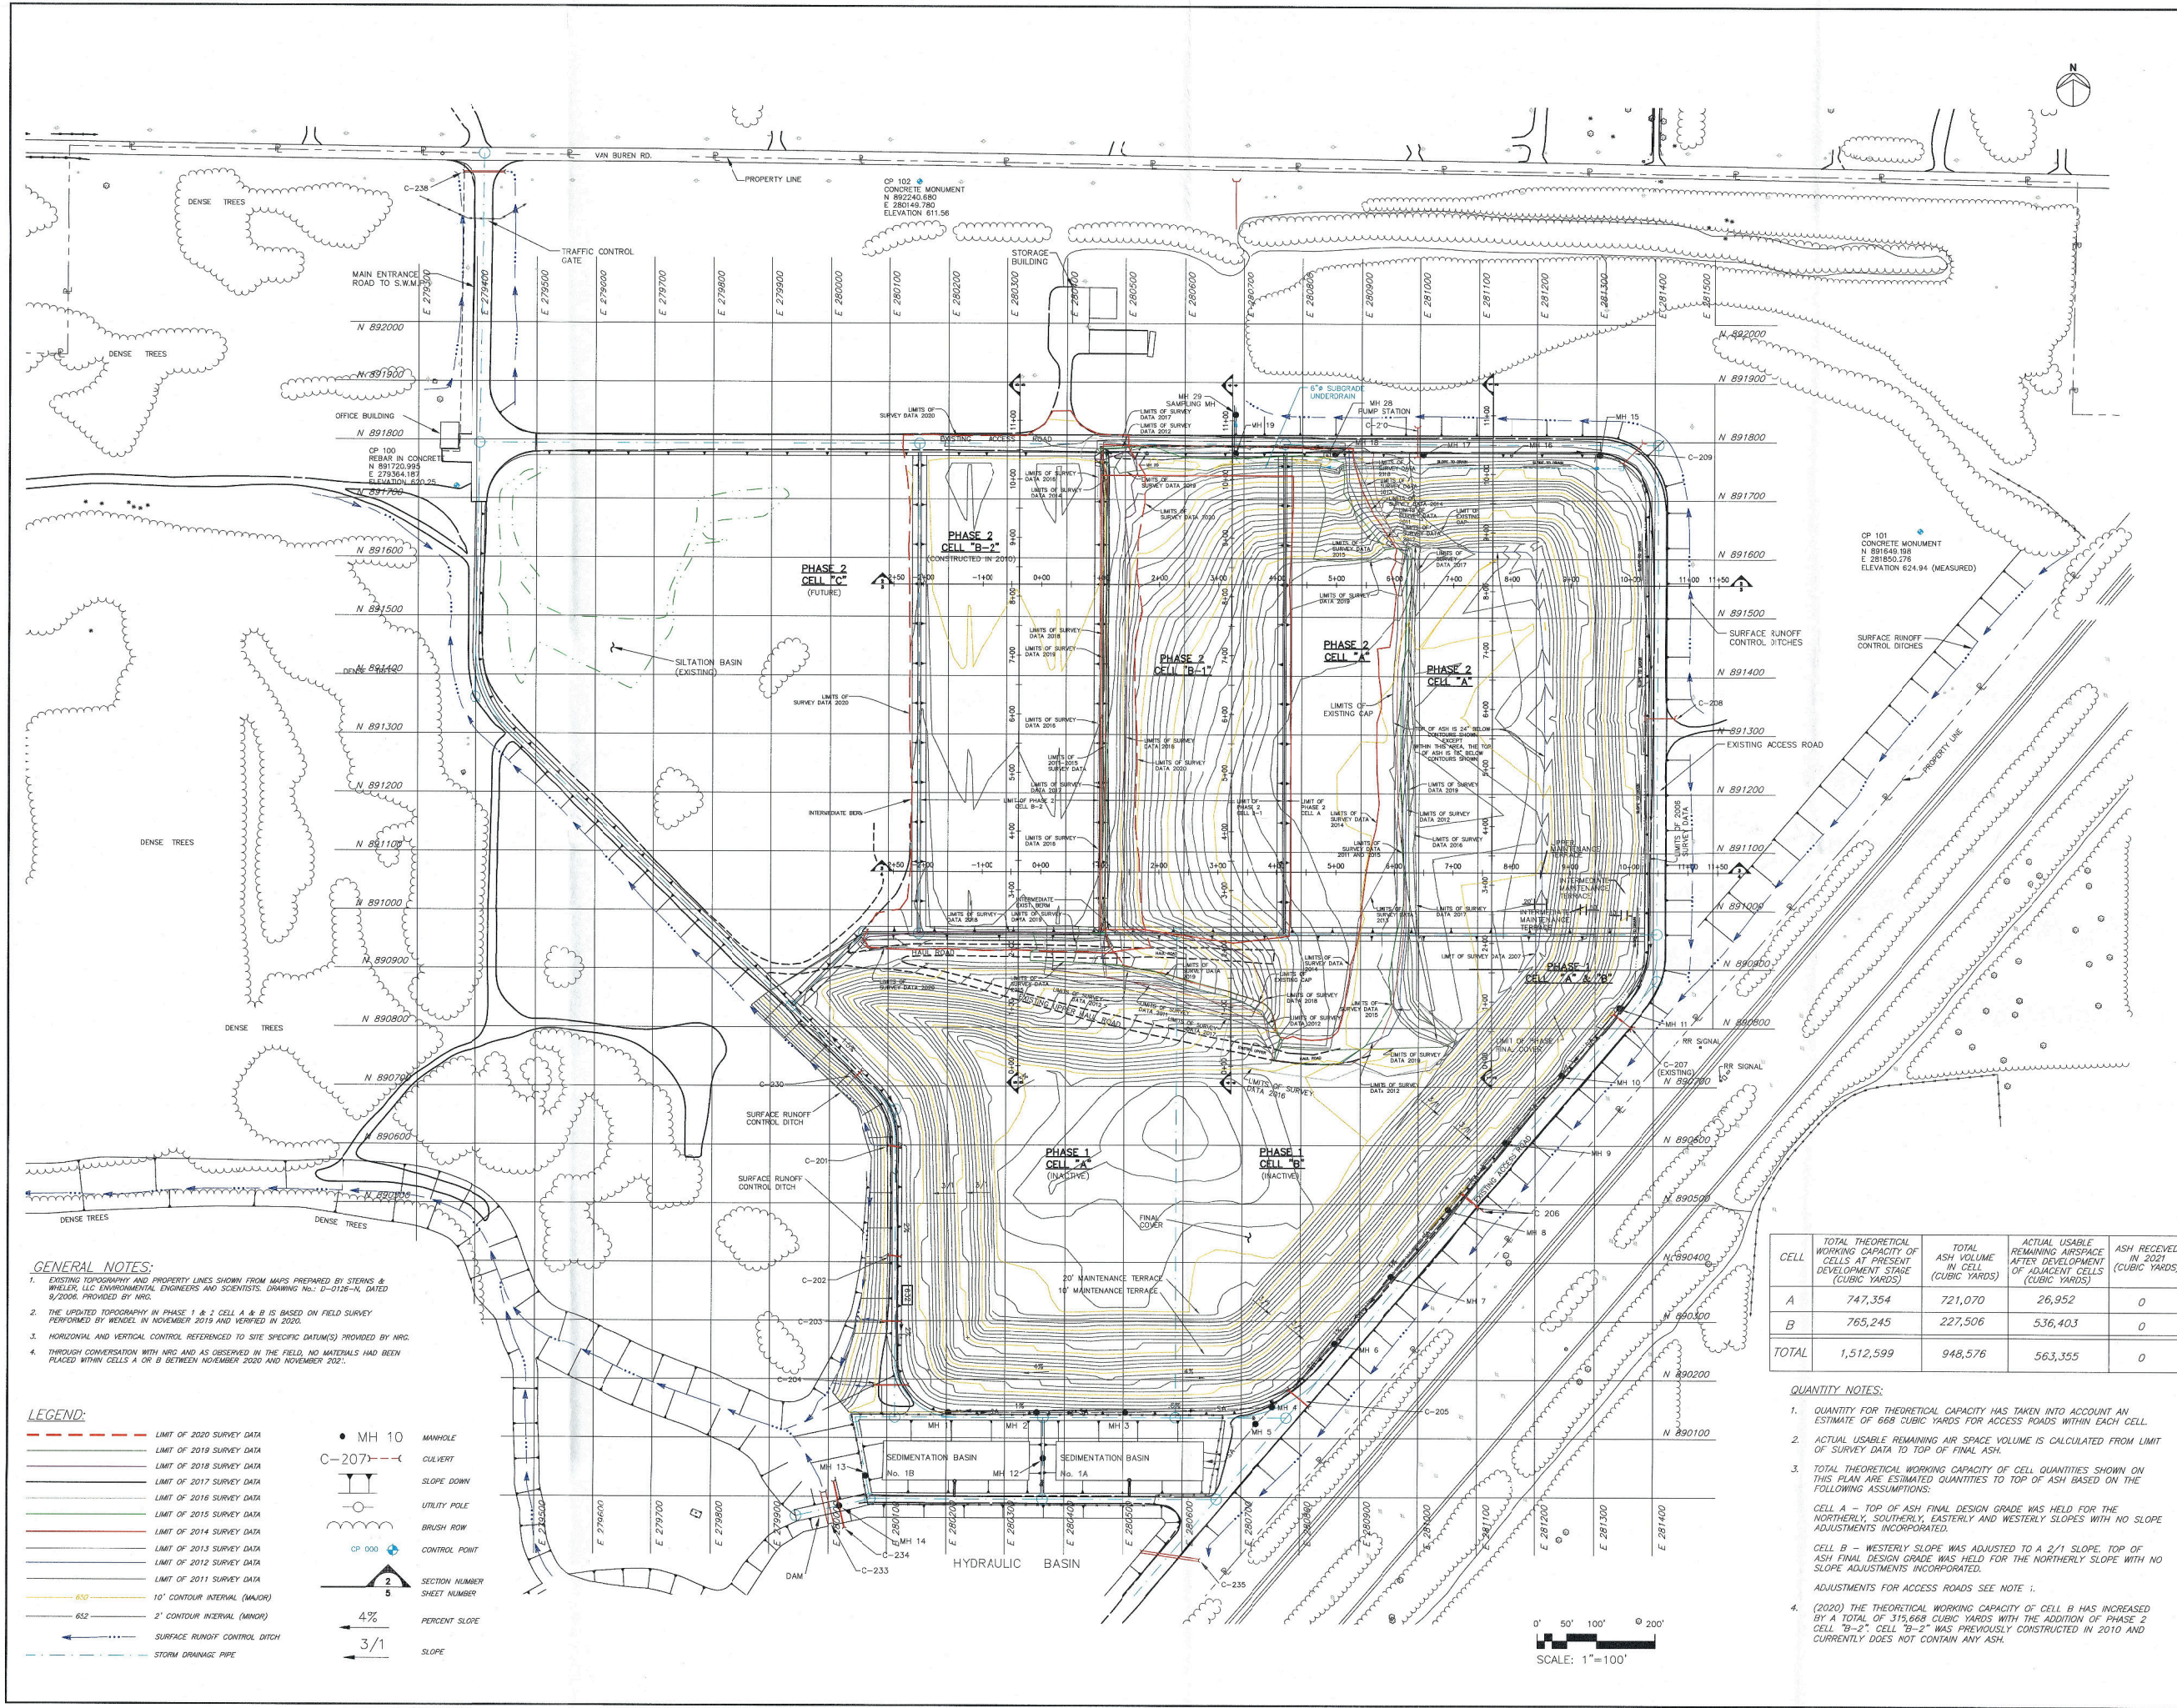

**GENERAL NOTES:**

- EXISTING TOPOGRAPHY AND PROPERTY LINES SHOWN FROM MAPS PREPARED BY STERNS & WENZEL, LLC ENVIRONMENTAL ENGINEERS AND SCIENTISTS, DRAWING No.: D-018-N, DATED 9/2006, PROVIDED BY NRG.
- THE UPDATED TOPOGRAPHY IN PHASE 1 & 2 CELL A & B IS BASED ON FIELD SURVEY PERFORMED BY WENDEL IN NOVEMBER 2019 AND VERIFIED IN 2020.
- HORIZONTAL AND VERTICAL CONTROL REFERENCED TO SITE SPECIFIC DATUM(S) PROVIDED BY NRG.
- THROUGH CONVERSATION WITH NRG AND AS OBSERVED IN THE FIELD, NO MATERIALS HAD BEEN PLACED WITHIN CELLS A OR B BETWEEN NOVEMBER 2020 AND NOVEMBER 2021.

**LEGEND:**

- LIMIT OF 2020 SURVEY DATA
- LIMIT OF 2019 SURVEY DATA
- LIMIT OF 2018 SURVEY DATA
- LIMIT OF 2017 SURVEY DATA
- LIMIT OF 2016 SURVEY DATA
- LIMIT OF 2015 SURVEY DATA
- LIMIT OF 2014 SURVEY DATA
- LIMIT OF 2013 SURVEY DATA
- LIMIT OF 2012 SURVEY DATA
- LIMIT OF 2011 SURVEY DATA
- 10' CONTOUR INTERVAL (MAJOR)
- 5' CONTOUR INTERVAL (MINOR)
- SURFACE RUNOFF CONTROL DITCH
- STORM DRAINAGE PIPE
- MH 10 MANHOLE
- C-207-1 CULVERT
- SLOPE DOWN
- UTILITY POLE
- BRUSH ROW
- CP 000 CONTROL POINT
- SECTION NUMBER SHEET NUMBER
- 4% PERCENT SLOPE
- 3/1 SLOPE

CELL	TOTAL THEORETICAL WORKING CAPACITY OF CELLS AT PRESENT DEVELOPMENT STAGE (CUBIC YARDS)	TOTAL ASH VOLUME IN CELL (CUBIC YARDS)	ACTUAL USABLE REMAINING AIR SPACE AFTER DEVELOPMENT OF ADJACENT CELLS (CUBIC YARDS)	ASH RECEIVED IN 2021 (CUBIC YARDS)
A	747,354	721,070	26,952	0
B	765,245	227,506	536,403	0
TOTAL	1,512,599	948,576	563,355	0

**QUANTITY NOTES:**

- QUANTITY FOR THEORETICAL CAPACITY HAS TAKEN INTO ACCOUNT AN ESTIMATE OF 668 CUBIC YARDS FOR ACCESS ROADS WITHIN EACH CELL.
- ACTUAL USABLE REMAINING AIR SPACE VOLUME IS CALCULATED FROM LIMIT OF SURVEY DATA TO TOP OF FINAL ASH.
- TOTAL THEORETICAL WORKING CAPACITY OF CELL QUANTITIES SHOWN ON THIS PLAN ARE ESTIMATED QUANTITIES TO TOP OF ASH BASED ON THE FOLLOWING ASSUMPTIONS:  
 CELL A - TOP OF ASH FINAL DESIGN GRADE WAS HELD FOR THE NORTHERLY, SOUTHERLY, EASTERLY AND WESTERLY SLOPES WITH NO SLOPE ADJUSTMENTS INCORPORATED.  
 CELL B - WESTERLY SLOPE WAS ADJUSTED TO A 2/1 SLOPE. TOP OF ASH FINAL DESIGN GRADE WAS HELD FOR THE NORTHERLY SLOPE WITH NO SLOPE ADJUSTMENTS INCORPORATED.  
 ADJUSTMENTS FOR ACCESS ROADS SEE NOTE 1.
- (2020) THE THEORETICAL WORKING CAPACITY OF CELL B HAS INCREASED BY A TOTAL OF 315,668 CUBIC YARDS WITH THE ADDITION OF PHASE 2 CELL "B-2". CELL "B-2" WAS PREVIOUSLY CONSTRUCTED IN 2010 AND CURRENTLY DOES NOT CONTAIN ANY ASH.

