



water resources / environmental consultants

**GROUNDWATER MONITORING
NETWORK EVALUATION
PLUM POINT ENERGY STATION
COAL COMBUSTION RESIDUAL LANDFILL**

**PREPARED IN COMPLIANCE WITH THE
EPA FINAL RULE FOR THE DISPOSAL OF
COAL COMBUSTION RESIDUALS
TITLE 40 CODE OF FEDERAL REGULATIONS PART 257**

OCTOBER 9, 2017

GROUNDWATER MONITORING NETWORK EVALUATION
PLUM POINT ENERGY STATION
COAL COMBUSTION RESIDUAL LANDFILL

PREPARED IN COMPLIANCE WITH THE
EPA FINAL RULE FOR THE DISPOSAL OF COAL COMBUSTION RESIDUALS
TITLE 40 CODE OF FEDERAL REGULATIONS PART 257

Prepared for

Plum Point Services Company, LLC
Plum Point Energy Station
2732 South County Road 623
Osceola, AR 72370

Prepared by


FTN Associates, Ltd.
3 Innwood Circle, Suite 220
Little Rock, AR 72211

FTN No. R14590-1621-001

October 9, 2017

PROFESSIONAL ENGINEER'S CERTIFICATION

With this certification, I certify that I am a qualified professional engineer as defined in §257.53 of Title 40 Code of Federal Regulations Part 257, that I have reviewed the available documents discussed in this report, and that the groundwater monitoring network described herein meets the requirements of §257.91 of 40 CFR Part 257.

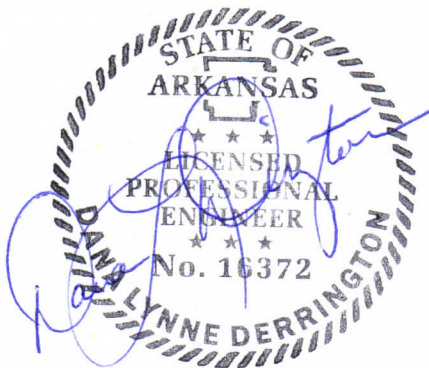

Dana L. Derrington, Arkansas PE #16372

10-09-2017
Date

TABLE OF CONTENTS

PROFESSIONAL ENGINEER’S CERTIFICATION	i
1.0 INTRODUCTION	1-1
2.0 BACKGROUND	2-1
2.1 Location Description.....	2-1
2.2 Operational History.....	2-1
2.3 Previous Investigations	2-4
2.4 Groundwater Monitoring Well Network	2-4
3.0 HYDROGEOLOGICAL SETTING.....	3-1
3.1 Regional Hydrogeological Setting.....	3-1
3.2 Hydrogeological Data at the Landfill	3-4
3.3 Hydraulic Gradient, Rate, and Direction of Groundwater Flow.....	3-4
4.0 REVIEW OF MONITORING NETWORK.....	4-1
4.1 Uppermost Aquifer and Vertical Placement of Monitoring Wells	4-1
4.2 Location of Monitoring Wells Relative to CCR Unit.....	4-1
4.2.1 Monitoring Wells that Monitor Background Water Quality.....	4-1
4.2.2 Downgradient Compliance Monitoring Wells.....	4-3
4.3 Monitoring Well Construction and Development.....	4-3
5.0 REFERENCES	5-1

LIST OF APPENDICES

APPENDIX A:	Boring Logs and Monitoring Well Construction Diagrams
APPENDIX B:	Geologic Cross-Sections

LIST OF TABLES

Table 2.1	Summary of monitoring well construction data.....	2-5
Table 3.1	Estimated hydraulic gradient and groundwater flow rate across Cell 1 and Cell 3	3-9

LIST OF FIGURES

Figure 1.1	Location map	1-2
Figure 2.1	Vicinity map.....	2-2
Figure 2.2	Landfill site map	2-3
Figure 3.1	Physiographic regions (adapted from Schrader 2015).....	3-2
Figure 3.2	Regional potentiometric surface map (adapted from Schrader 2015)	3-3
Figure 3.3	Potentiometric surface, January 2016.....	3-5
Figure 3.4	Potentiometric surface, April 2017.....	3-6
Figure 3.5	Potentiometric surface, July 2016.....	3-7
Figure 3.6	Potentiometric surface, October 2015.....	3-8

1.0 INTRODUCTION

Plum Point Services Company, LLC (PPSC) operates a landfill for the disposal of coal combustion residuals (CCRs) the Plum Point Energy Station in Mississippi County, Arkansas. The plant and landfill are located approximately 2 miles south of the city of Osceola, as shown on Figure 1.1. The landfill is permitted by the Arkansas Department of Environmental Quality (ADEQ) under Permit No. 0303-S3N-R1 and became active during March 2010. Groundwater detection monitoring was initiated at the landfill in November 2007, in accordance with Arkansas Pollution Control and Ecology Commission (APCEC) Regulation No. 22 requirements.

The landfill's groundwater monitoring system was recently expanded to conform to the groundwater monitoring requirements of the Environmental Protection Agency (EPA) final rule for the disposal of coal combustion residuals (hereafter referred to as the CCR Rule) promulgated at Title 40 Code of Federal Regulations (40 CFR) Part 257 and published on April 17, 2015. Facilities regulated under this new rule are required by §257.91(f) to obtain a certification from a qualified professional engineer that the groundwater monitoring system meets the requirements of §257.91. This report has been prepared by FTN Associates, Ltd. (FTN), on behalf of PPSC to document an assessment of the landfill's groundwater monitoring network to ensure it meets the requirements of §257.91.

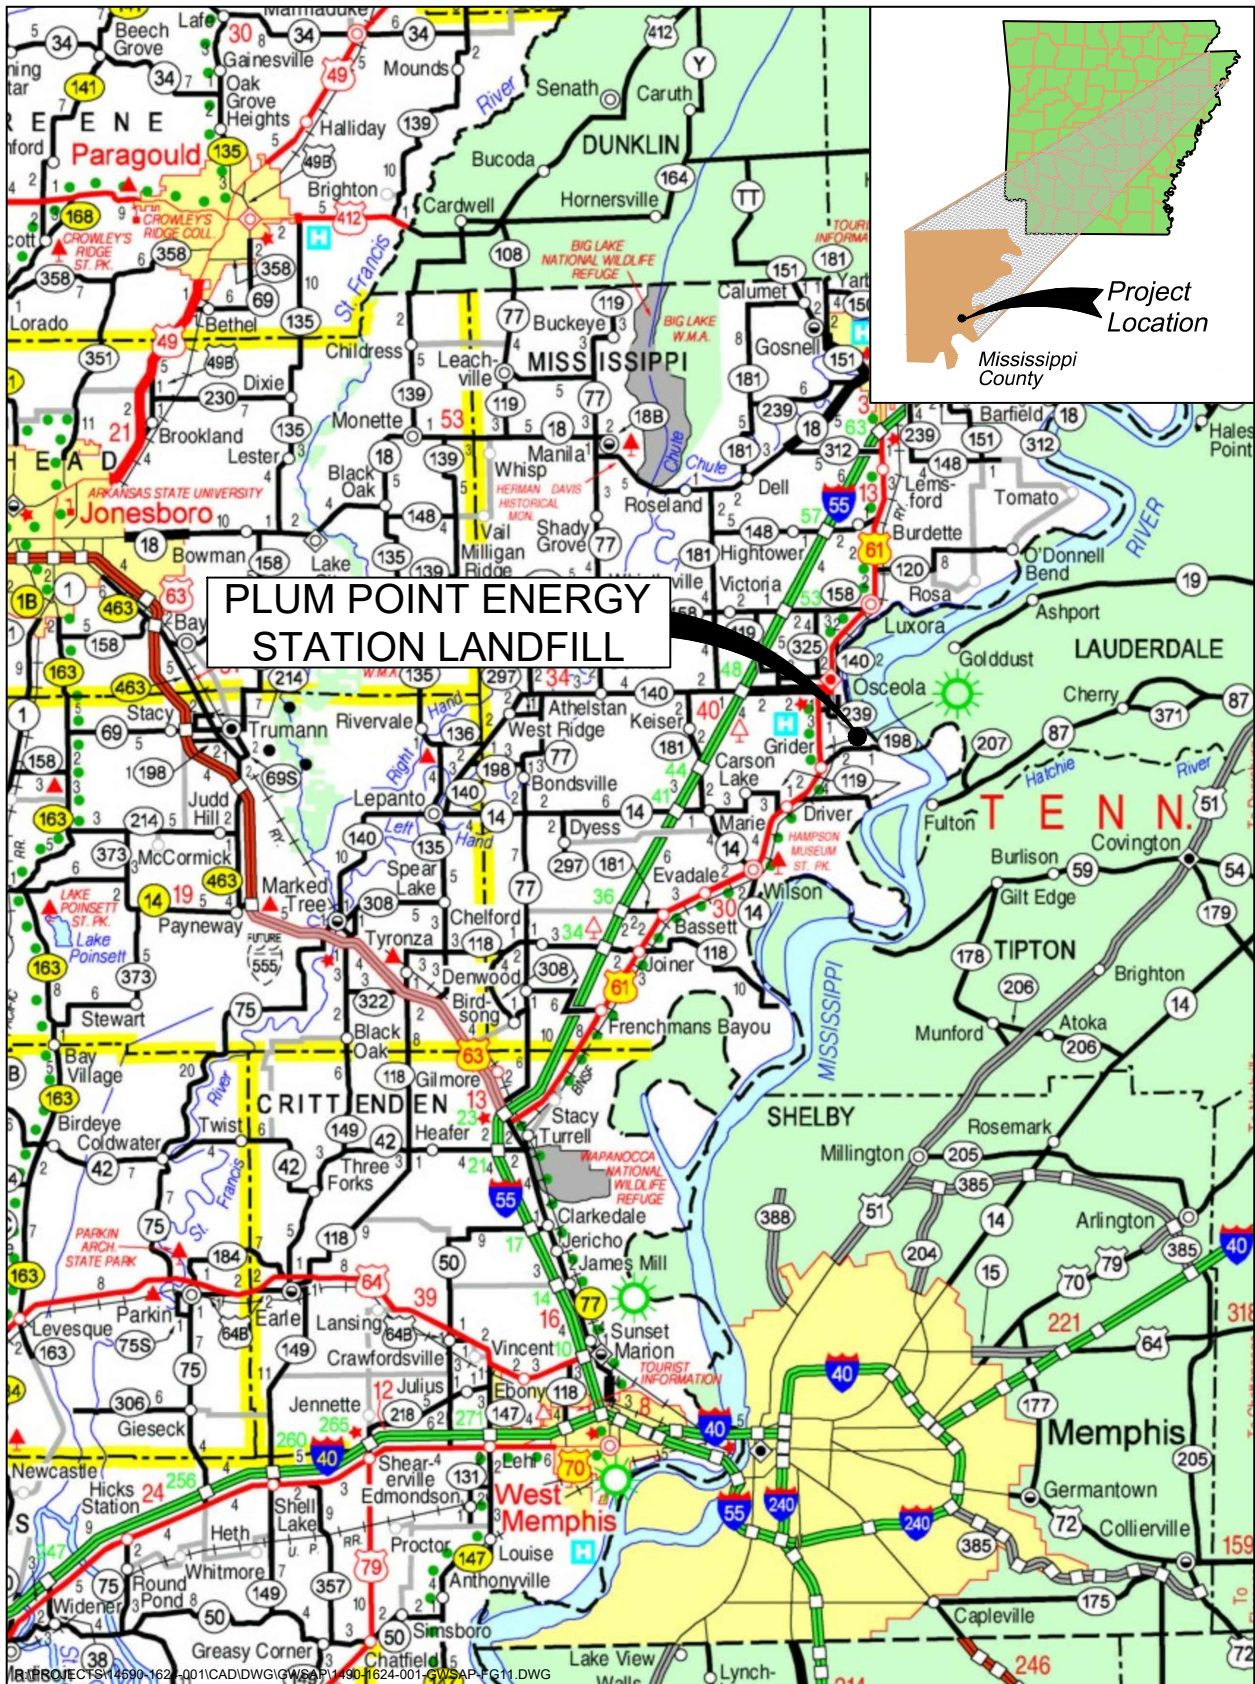


Figure 1.1. Location map.

2.0 BACKGROUND

This section includes a brief description of the location and operation of the plant and landfill, a summary of relevant previous investigations at the landfill, and a description of the existing monitoring well network maintained under the CCR Rule.

2.1 Location Description

The landfill area encompasses approximately 245 acres located approximately 1 mile west of the Mississippi River and 2 miles south of Osceola, Arkansas. The landfill is bordered by Arkansas Highway 239 to the east, Arkansas Highway 198 to the south, and the BNSF rail line to the west. Beyond these features and immediately north of the landfill are agricultural fields, and topography is relatively flat. A vicinity map of the Plum Point Energy Station and landfill is provided as Figure 2.1.

2.2 Operational History

The plant has been in operation since 2010 and generates electricity through the combustion of coal. Approximately 500,000 tons of CCR material is produced and deposited in the landfill each year. The landfill currently has two open disposal cells, Cells 1 and 3, which are shown on Figure 2.2. The combined area of the two CCR disposal cells is approximately 30 acres.


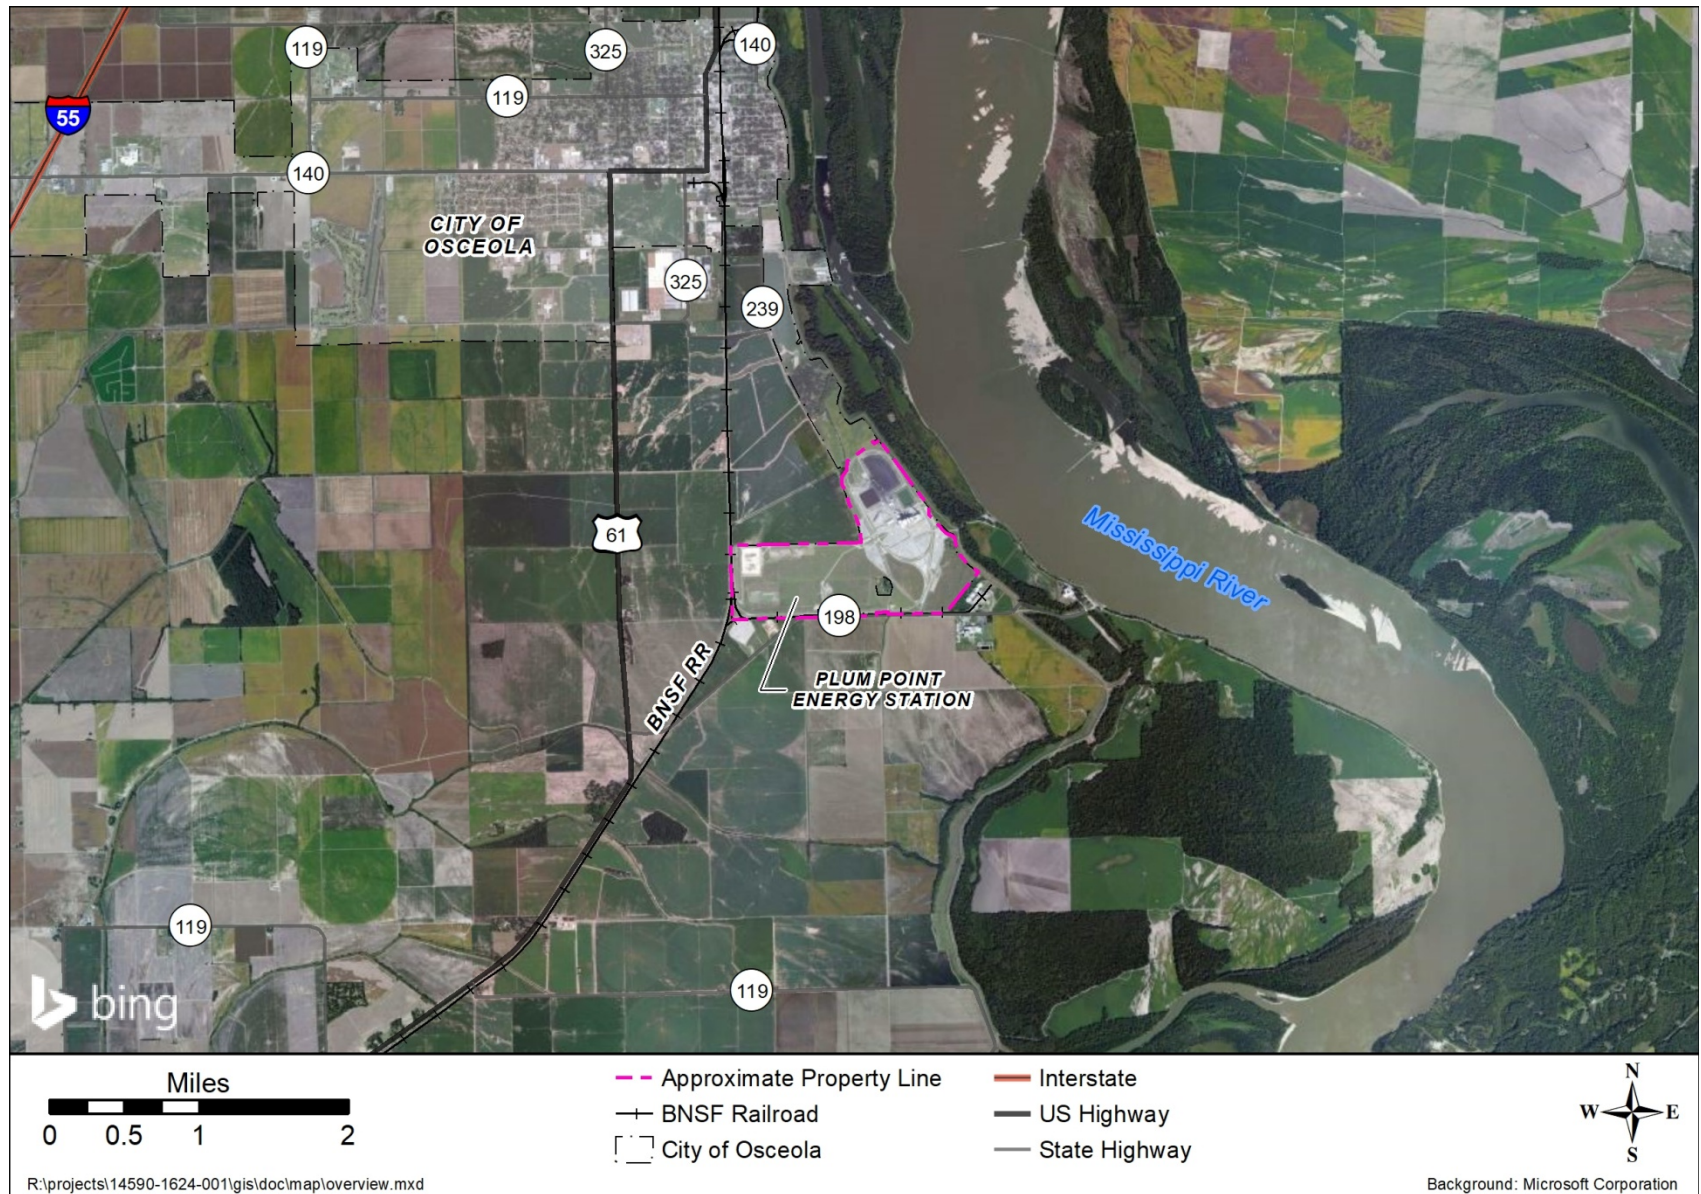


Figure 2.1. Vicinity map.

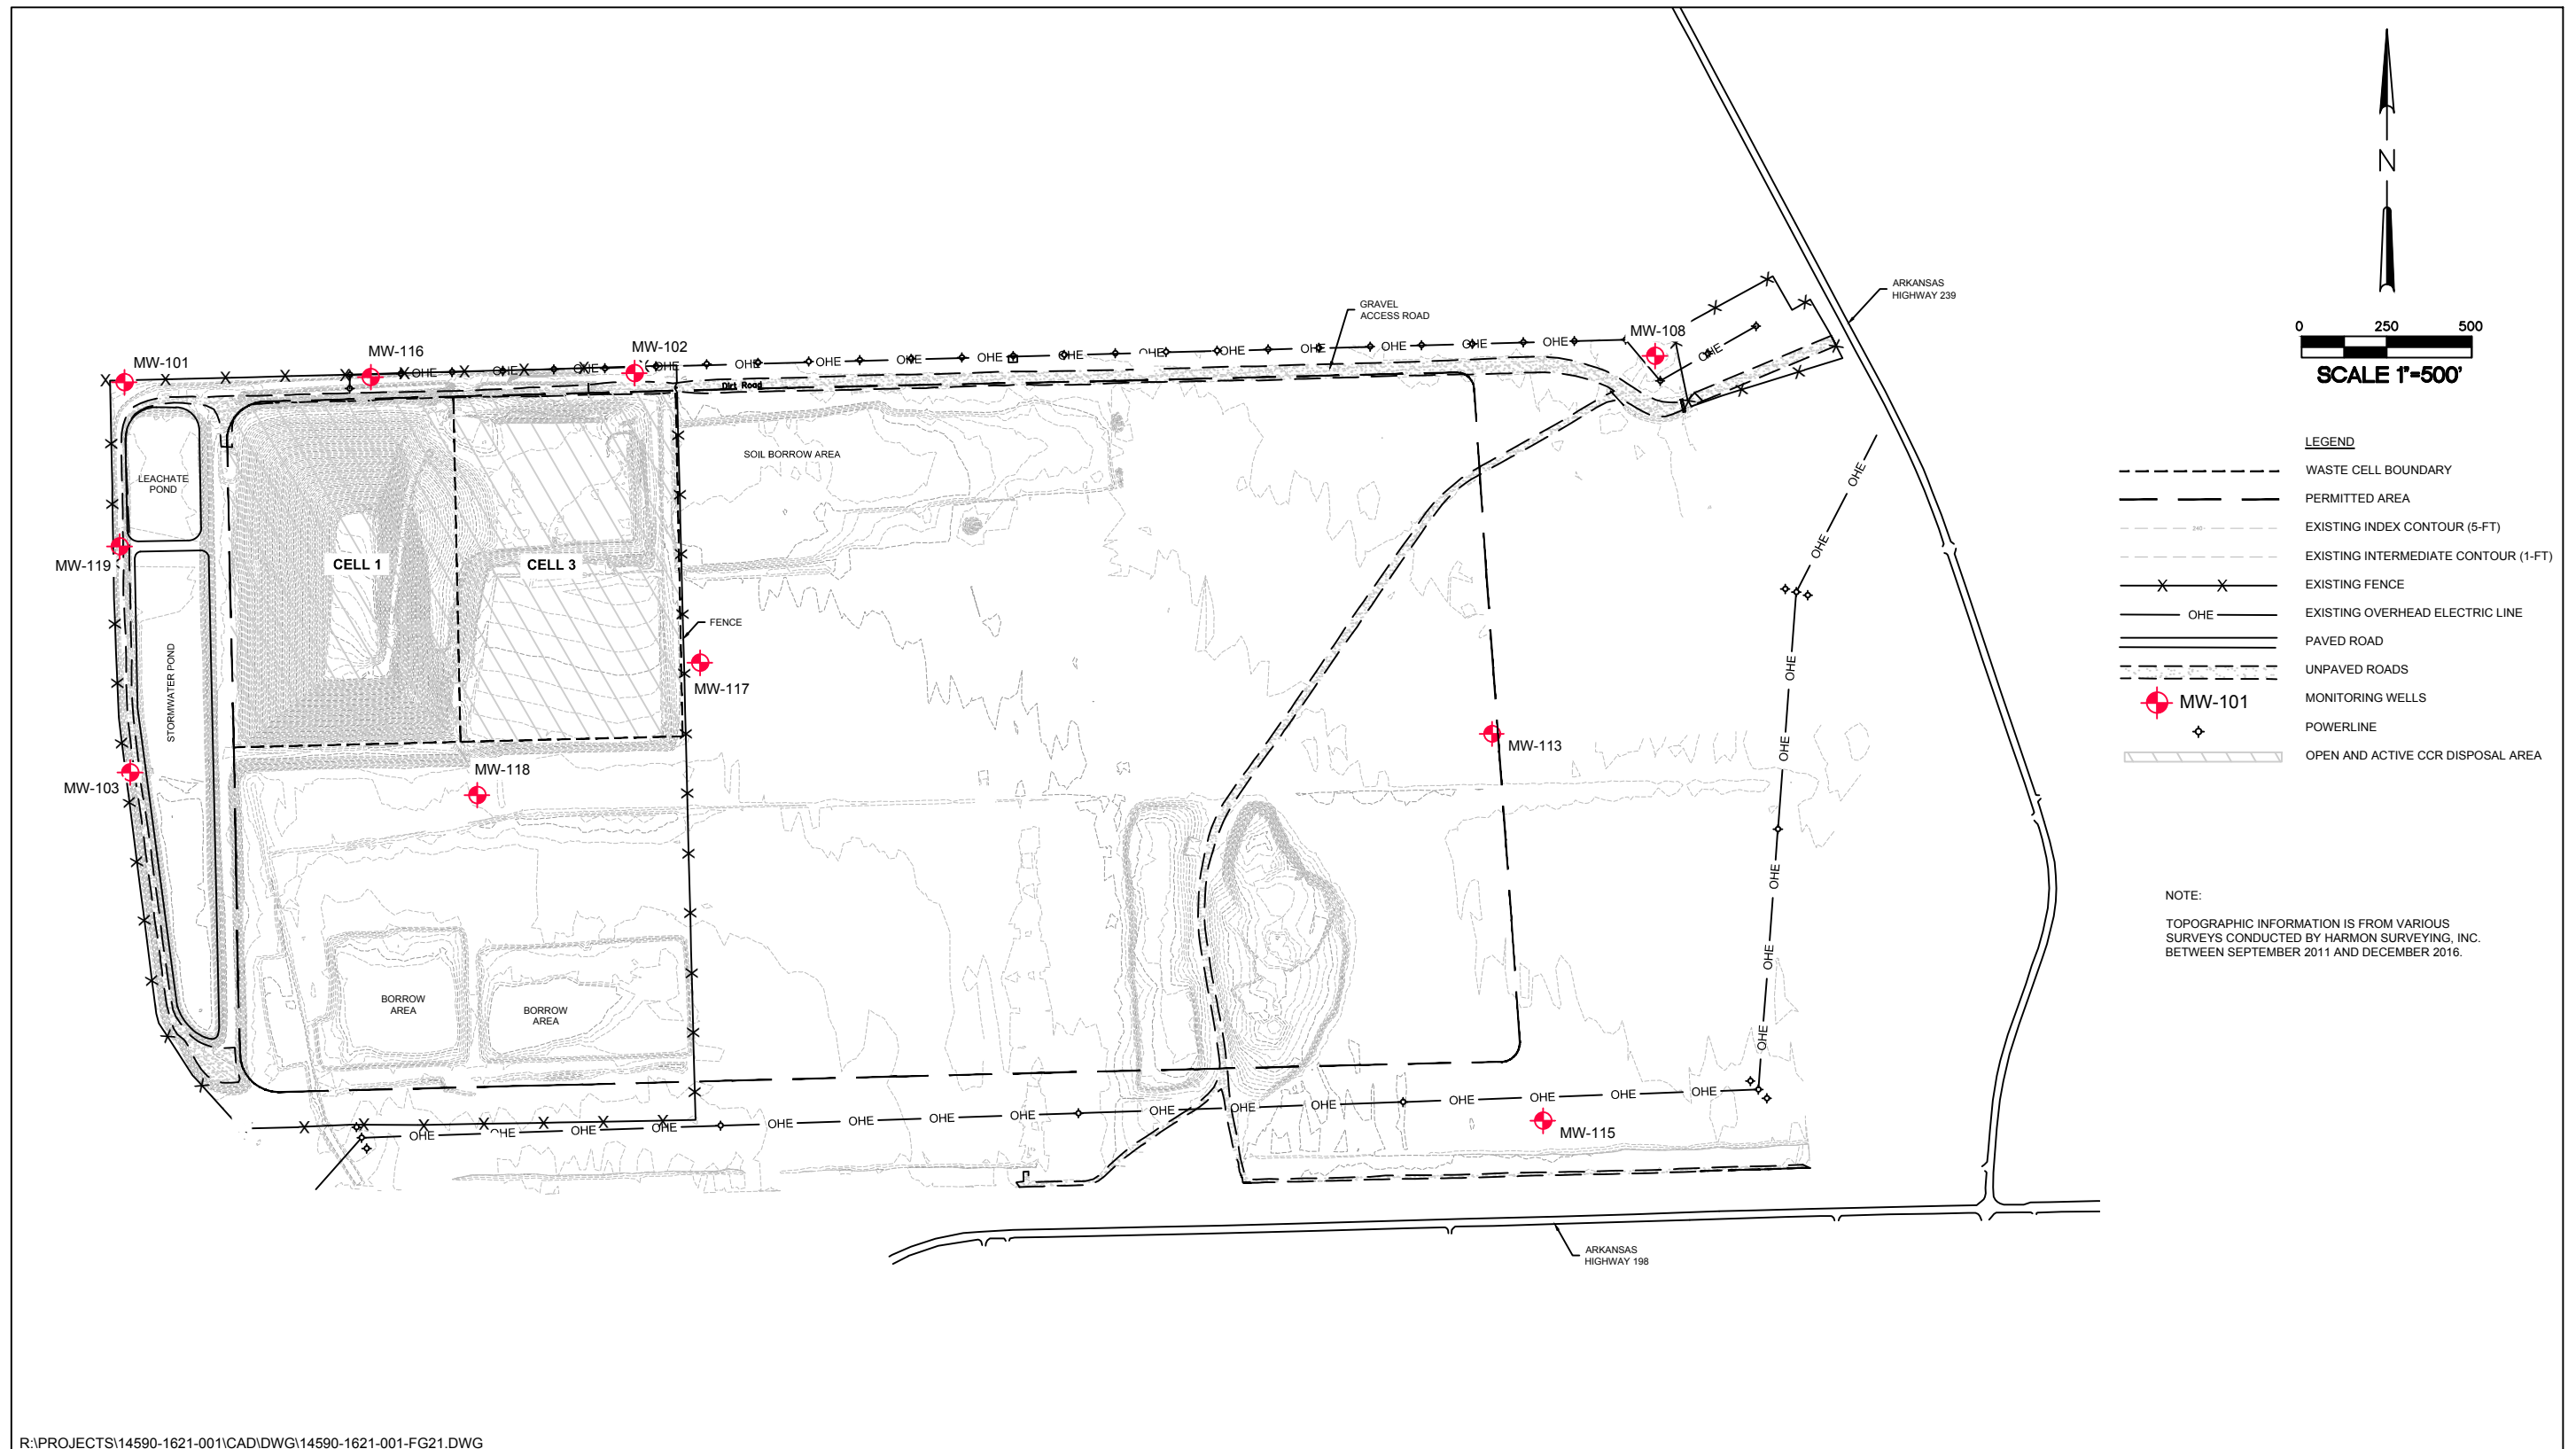

R:\PROJECTS\14590-1621-001\CAD\DWG\14590-1621-001-FG21.DWG

Figure 2.2. Landfill site map.

2.3 Previous Investigations

A detailed site investigation was performed in 2001 as part of the permit application for the landfill. The findings from the investigation were submitted to ADEQ by Genesis Environmental Consulting, Inc. (GEC), in a geotechnical and hydrogeological investigation (GHI) report (GEC 2001). The report generally included a review of the regional geological and hydrogeological setting of the landfill, a description of surface and subsurface exploration activities at the landfill site, a characterization of onsite lithology and hydrogeological conditions, and results for geotechnical testing of onsite soils. The GHI report was reviewed as part of this evaluation.

In addition to the GHI report, four monitoring well installation reports submitted to ADEQ were reviewed and include a November 2007 report prepared by Edwards Engineering, PA; a May 2009 report prepared by Civil Engineering Associates, LLC; and two reports prepared by FTN during October 2015 and December 2016.

Other minor studies have been performed as part of landfill design submittals to ADEQ, but are beyond the scope of this review.

2.4 Groundwater Monitoring Well Network

The groundwater monitoring network for the CCR Rule includes the 10 monitoring wells shown on Figure 2.2. The wells are constructed of 2-inch, Schedule 40 polyvinyl chloride (PVC) pipe, with 10-ft slotted well screens. A summary of well construction details is included in Table 2.1. Available boring logs and well construction diagrams are included in Appendix A.

Table 2.1. Summary of monitoring well construction data.

Well Number	Well Installation Date	Ground Surface Elevation (ft NAVD)^(a)	Top of Casing (TOC) Elevation^(b) (ft NAVD)	Total Depth (ft below TOC)	Screen Interval (ft NAVD)^(a)
MW-101	4/9/2001	239.4	242.75	33.6	219.2-209.2
MW-102	4/9/2001	240.5	243.99	30.2	223.8-213.8
MW-103	9/26/2007	240.5	243.25	32.8	220.5-210.5
MW-108	4/11/2001	241.8	245.11	32.4	222.7-212.7
MW-113	4/07/2009	241.5	244.63	35.9	223.7-208.7
MW-115	9/25/2007	240.4	243.55	33.0	220.6-210.7
MW-116	6/23/2015	239.3	243.97	31.9	222.5-212.5
MW-117	6/24/2015	239.4	242.53	34.2	218.5-208.5
MW-118	6/24/2015	238.0	241.23	31.4	220.2-210.2
MW-119	10/6/2016	243.6	246.53	35.4	221.5-211.5

Notes:

a. North American Vertical Datum of 1988.

b. The elevation datum for the TOC elevation also corresponds to the measuring point (MP) elevation.

3.0 HYDROGEOLOGICAL SETTING

3.1 Regional Hydrogeological Setting

The landfill is located in the Mississippi Alluvial Plain physiographic region, as shown by Figure 3.1. The region was formed by the deposits of the Mississippi River and its tributaries and is generally flat-lying (Cushing, Boswell, and Hosman 1964). The Mississippi River Valley alluvial aquifer (hereafter referred to as the alluvial aquifer) underlies the Mississippi Alluvial Plain in eastern Arkansas and is the uppermost aquifer in the region.

The alluvial aquifer is comprised of unconsolidated Quaternary alluvial and terrace deposits of sands and gravels that grade upward to clays and silts that form a semi-confining to confining layer over much of the aquifer. Regionally, the alluvium reaches depths of 100 ft to 200 ft below ground surface (bgs) (Ryling 1960; Cushing, Boswell, and Hosman 1964). Published documents indicate that the alluvial aquifer commonly yields 2,000 gallons per minute (gpm) (Kresse et al. 2014).

The regional direction of flow in the alluvial aquifer is to the southwest, across Mississippi County, as shown by Figure 3.2 (Schrader 2015). Natural recharge to the alluvial aquifer in Mississippi County occurs primarily from influent seepage from the Mississippi River or from infiltration of rainfall in the northwestern corner of the county, where the confining unit is thin or absent (Ryling 1960; Cushing, Boswell, and Hosman 1964; Peterson, Broom, and Bush 1985).

Beneath the alluvial aquifer is the Tertiary-aged Jackson-Claiborne clay, which acts as a confining unit below the aquifer. The Jackson group contains dense marine clays and shale with occasional lenses of fine-grained sand (Peterson, Broom, and Bush 1985). The upper unit of the Claiborne is characterized by silty clay interbedded with thin and discontinuous beds of sand (Broom and Lyford 1981).

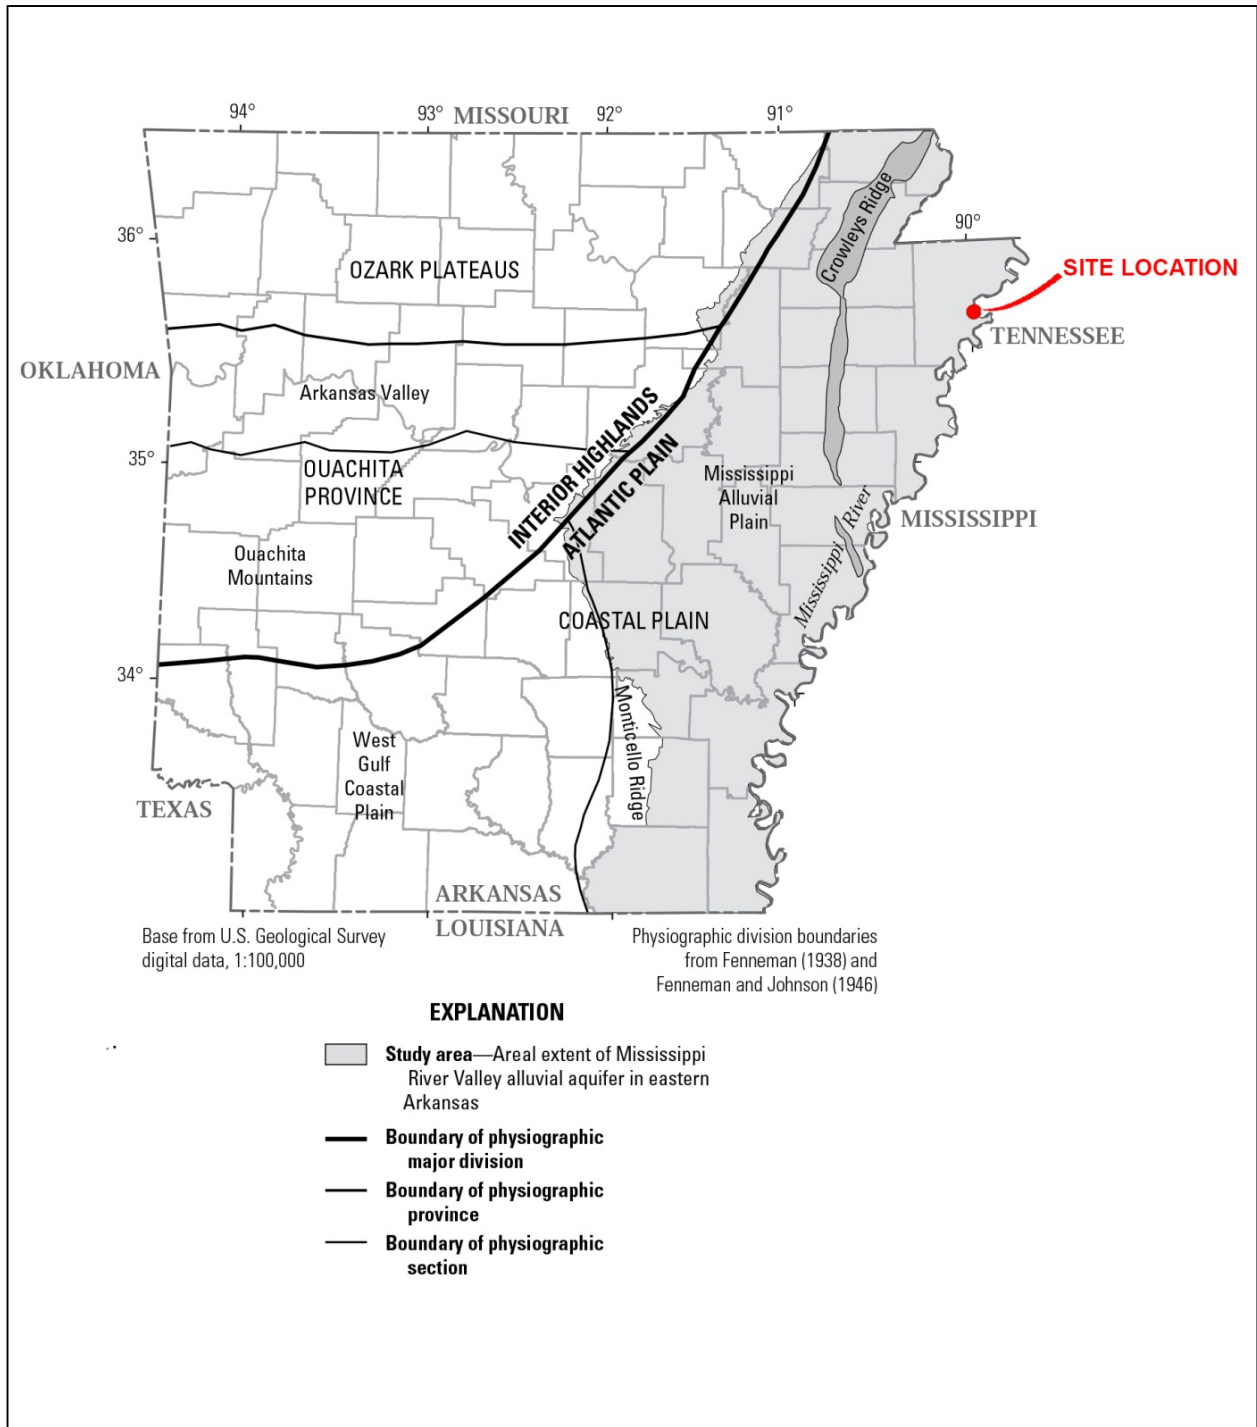


Figure 3.1. Physiographic regions (adapted from Schrader 2015).

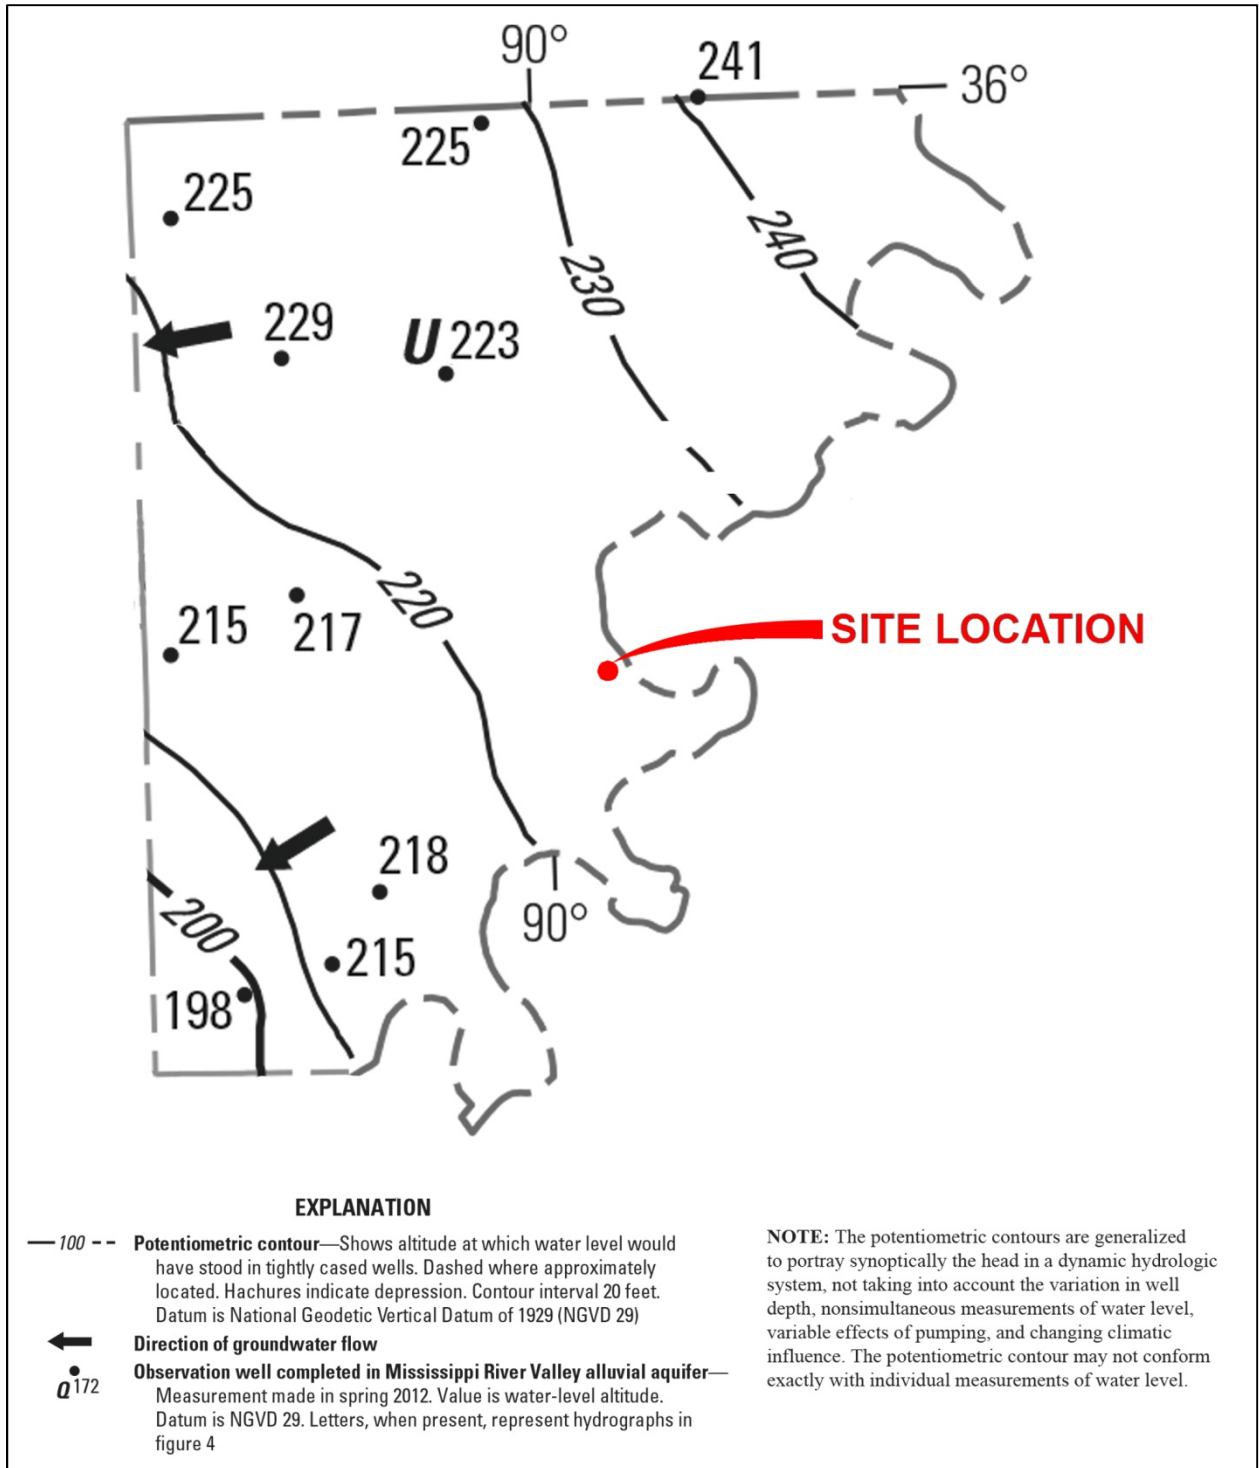


Figure 3.2. Regional potentiometric surface map (adapted from Schrader 2015).

3.2 Hydrogeological Data at the Landfill

The subsurface investigation described in the GHI report (GEC 2001) indicated that the local confining unit ranges from 0 ft to over 30 ft thick, with an average thickness of 15 ft. The local confining unit is comprised of brown to grey clay, silty clay, and sandy clays. Underlying the confining unit are fine- to coarse-grained sands of the alluvial aquifer, with fine- to coarse-grained gravel encountered at depth. Based on one deep boring, completed to a depth of 200 ft below ground surface (bgs), the coarse-grained aquifer materials reach a depth of 190 ft bgs in the vicinity of the landfill. Geologic cross-sections incorporating the landfill's monitoring wells and lithologic borings from the 2001 investigation are provided in Appendix B.

Laboratory geotechnical testing of confining unit soils indicate a vertical permeability of ranging from 6.7×10^{-4} centimeters per second (cm/s) to 3.7×10^{-8} cm/s. Field results from one pumping test and multiple slug tests indicate that the uppermost alluvial aquifer material has an average hydraulic conductivity of 1.09×10^{-2} cm/s (GEC 2001). The GHI reported an effective porosity for the aquifer of 27% (GEC 2001), which agrees with published values ranging from 10% to 30% for similar aquifer materials (EPA 1998, Yu et al. 2015).


3.3 Hydraulic Gradient, Rate, and Direction of Groundwater Flow

The direction of groundwater flow shifts on a seasonal basis at the landfill. Figures 3.3 through 3.6 include potentiometric surface maps that are typical based on measured water levels during the summer, fall, winter, and spring seasons.

The rate of groundwater flow beneath the landfill is estimated based on Darcy's law, modified to account for the open space available for groundwater flow within the aquifer. The resulting equation estimates the average linear groundwater velocity, or seepage flow, shown below (Kuo 1999):


$$V_x = K/n_e(dh/dl)$$

Where: V_x = average linear velocity,
 K = hydraulic conductivity,
 n_e = effective porosity, and
 dh/dl = hydraulic gradient.

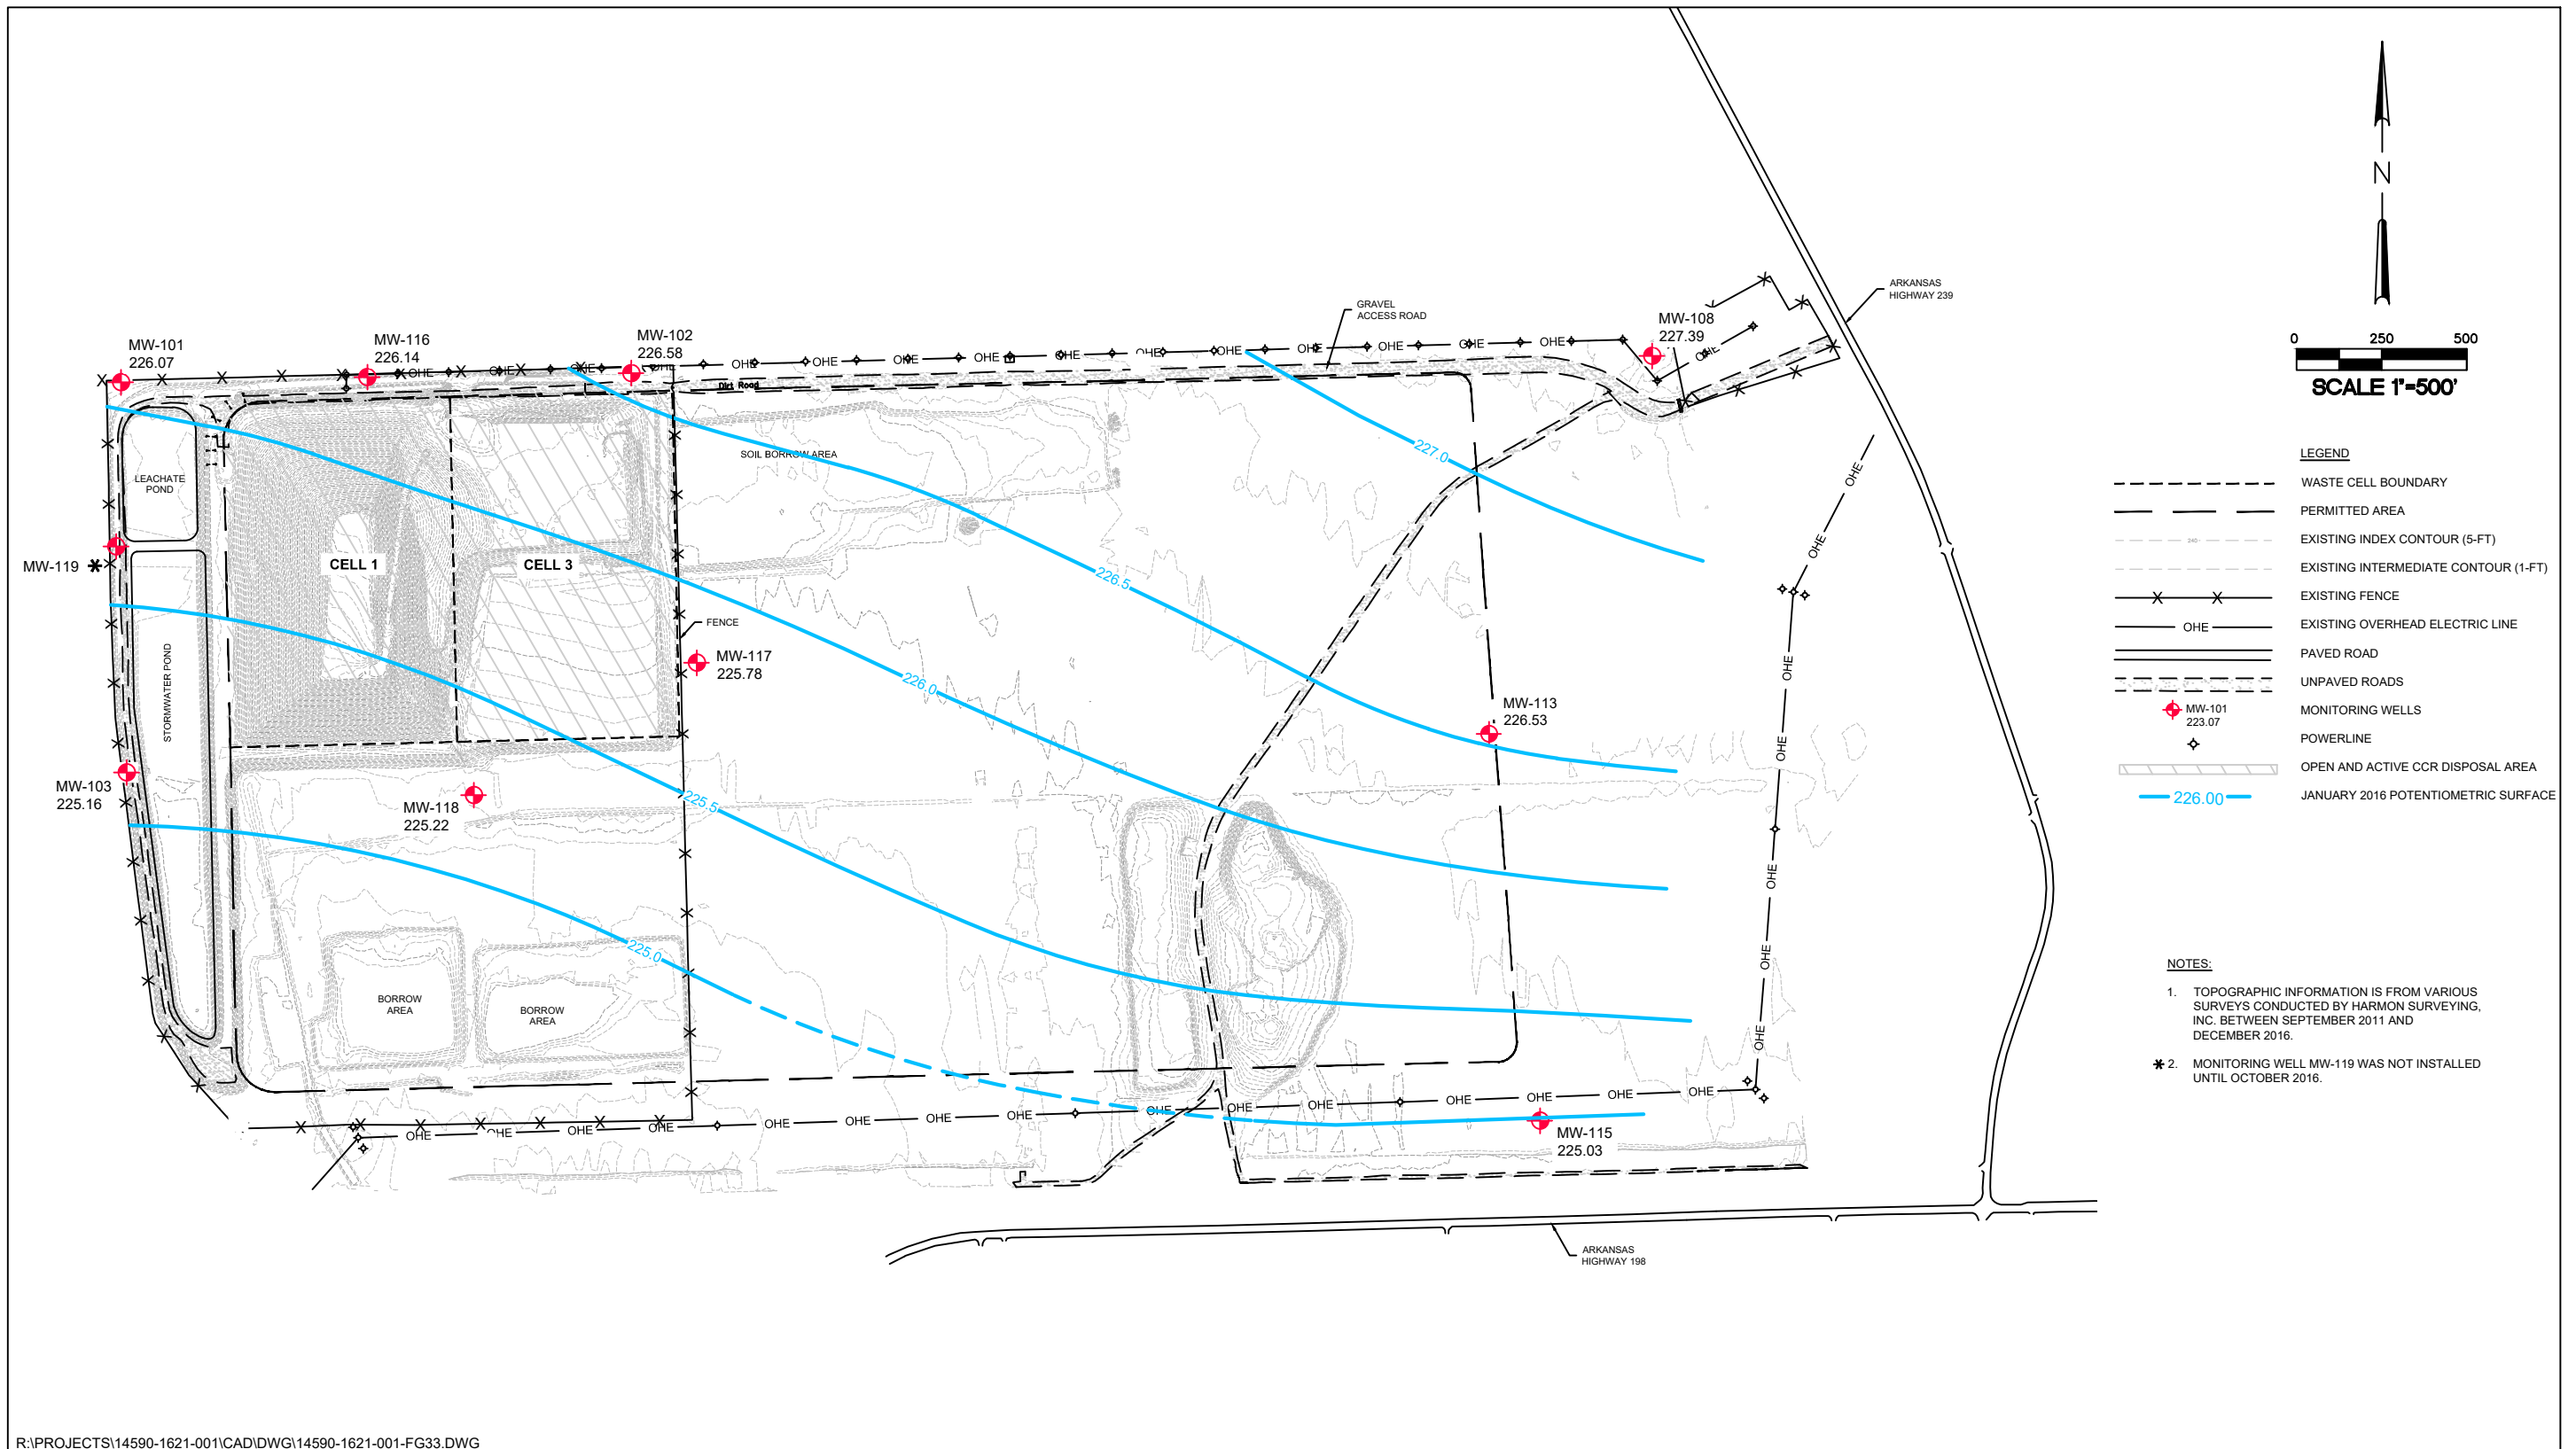

R:\PROJECTS\14590-1621-001\CAD\DWG\14590-1621-001-FG33.DWG

Figure 3.3. Potentiometric surface, January 2016.

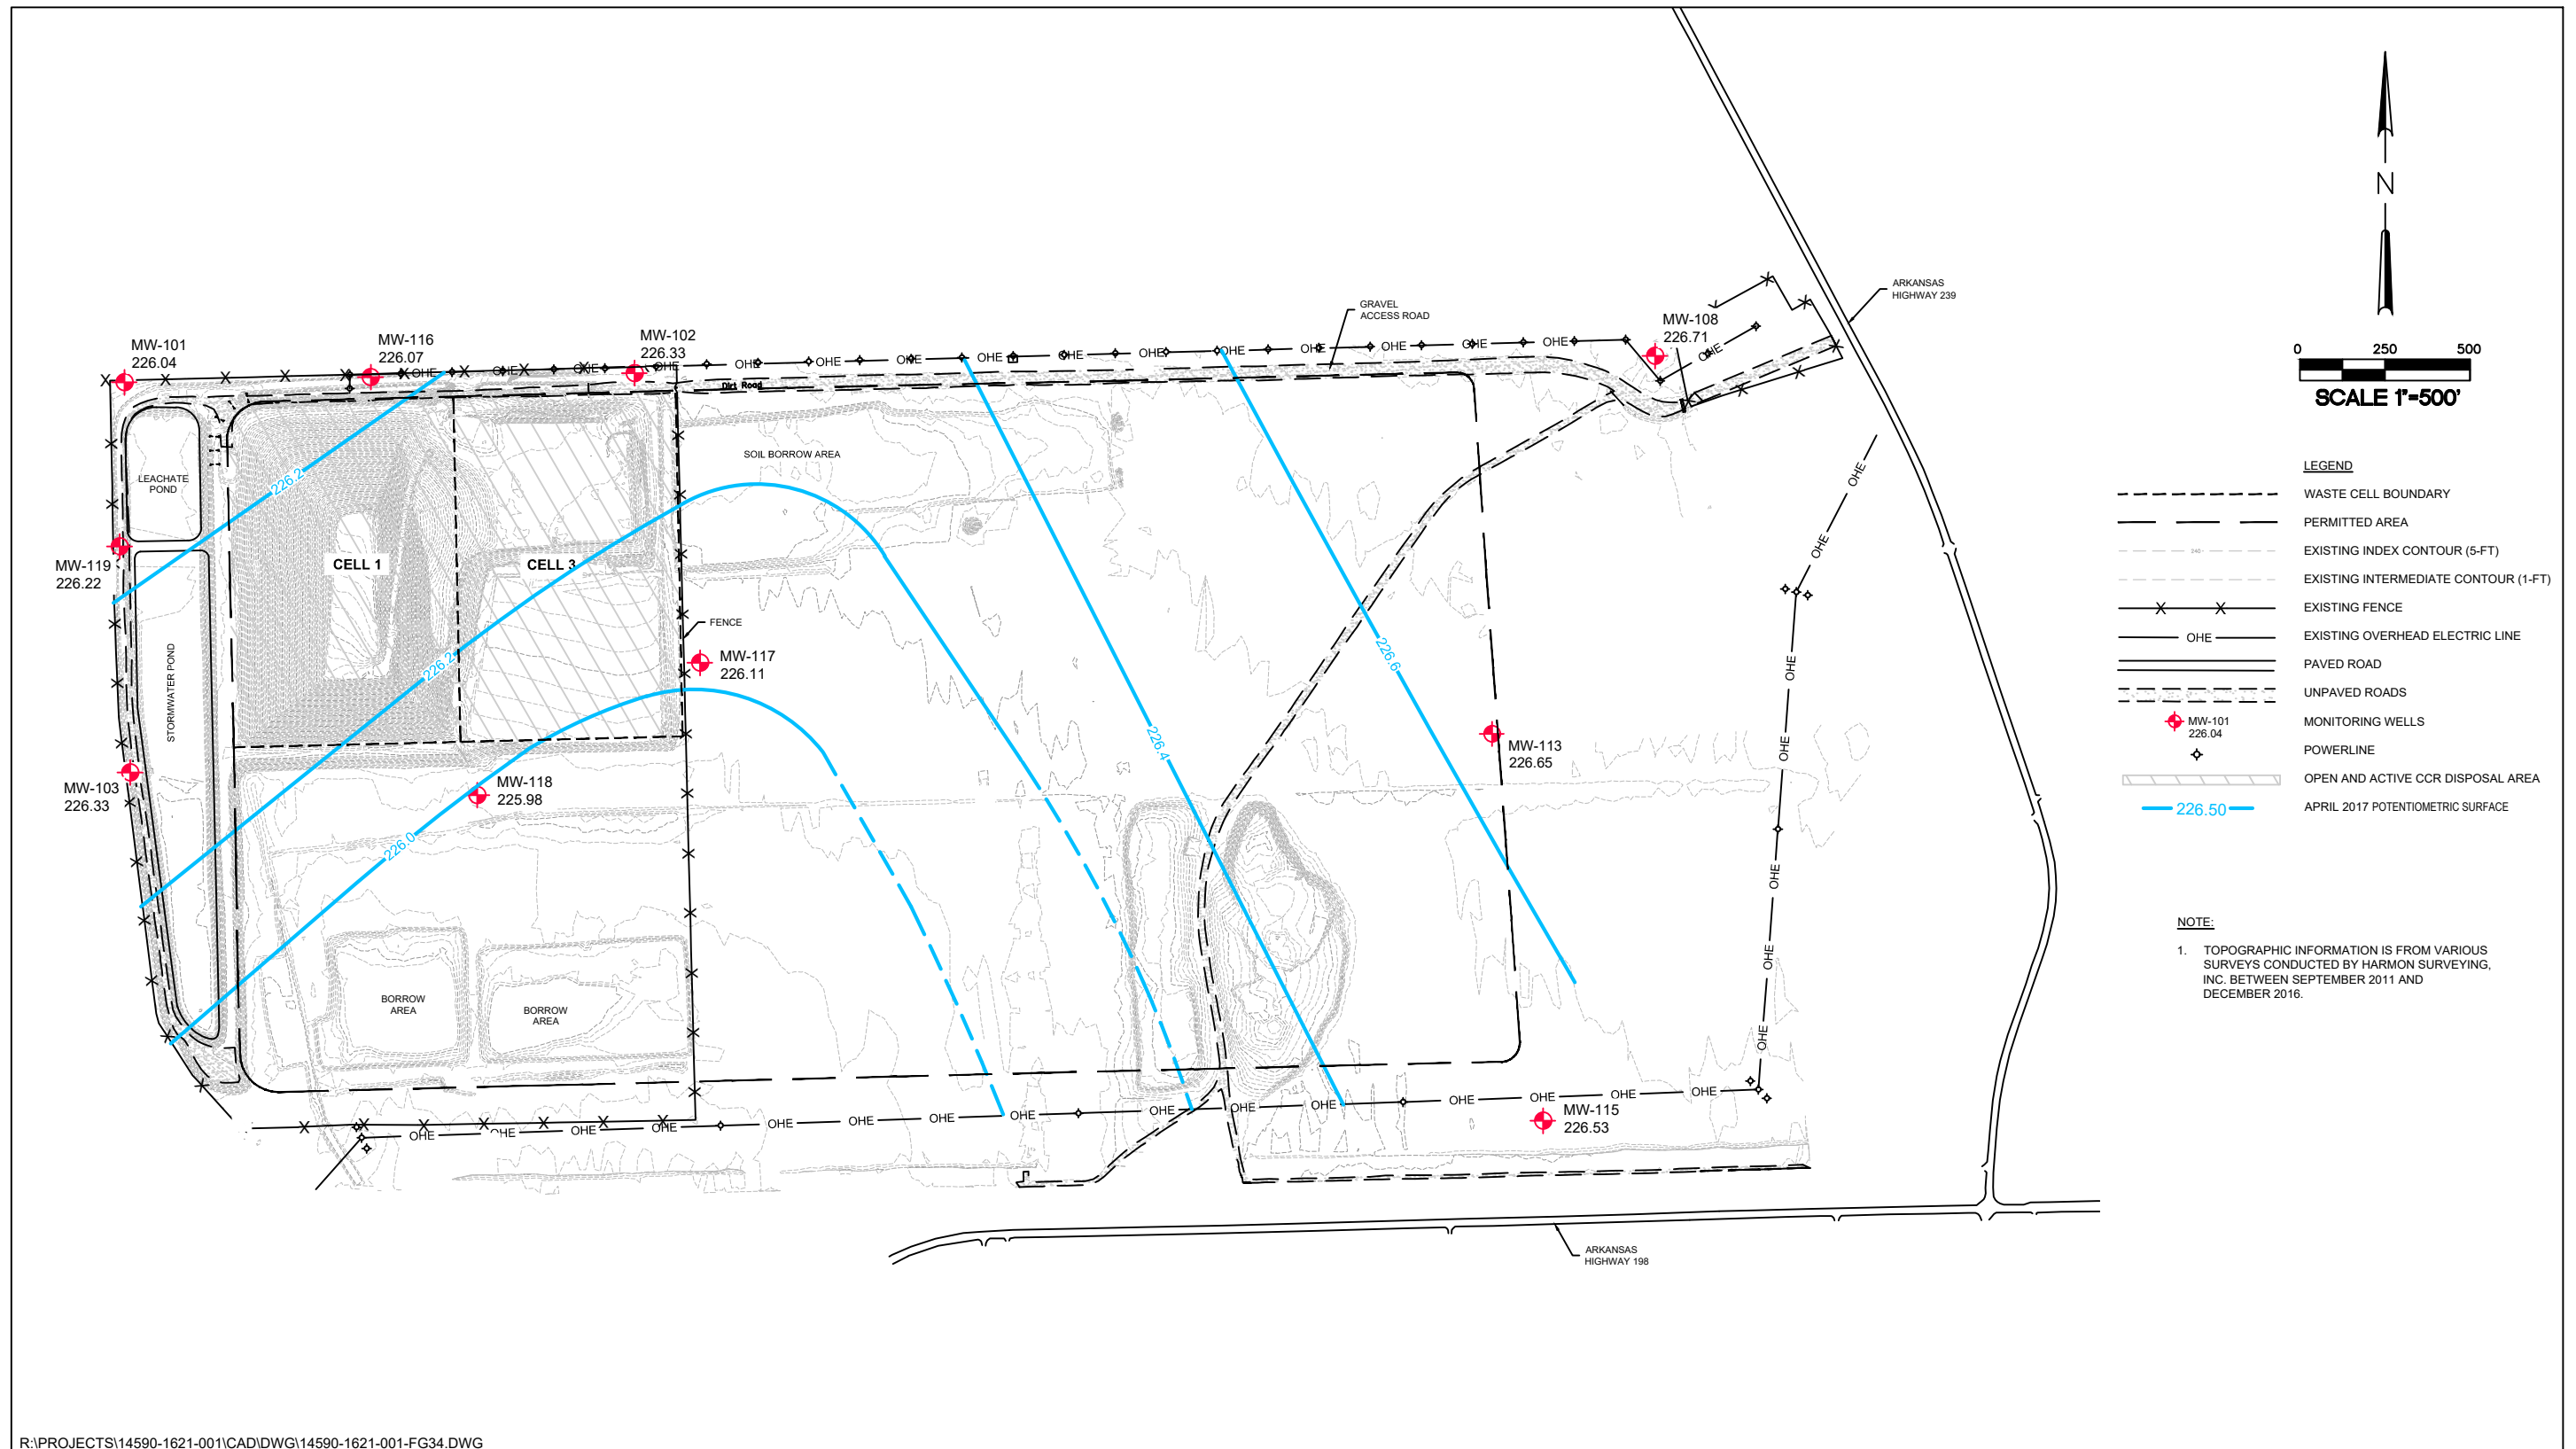

R:\PROJECTS\14590-1621-001\CAD\DWG\14590-1621-001-FG34.DWG

Figure 3.4. Potentiometric surface, April 2017.

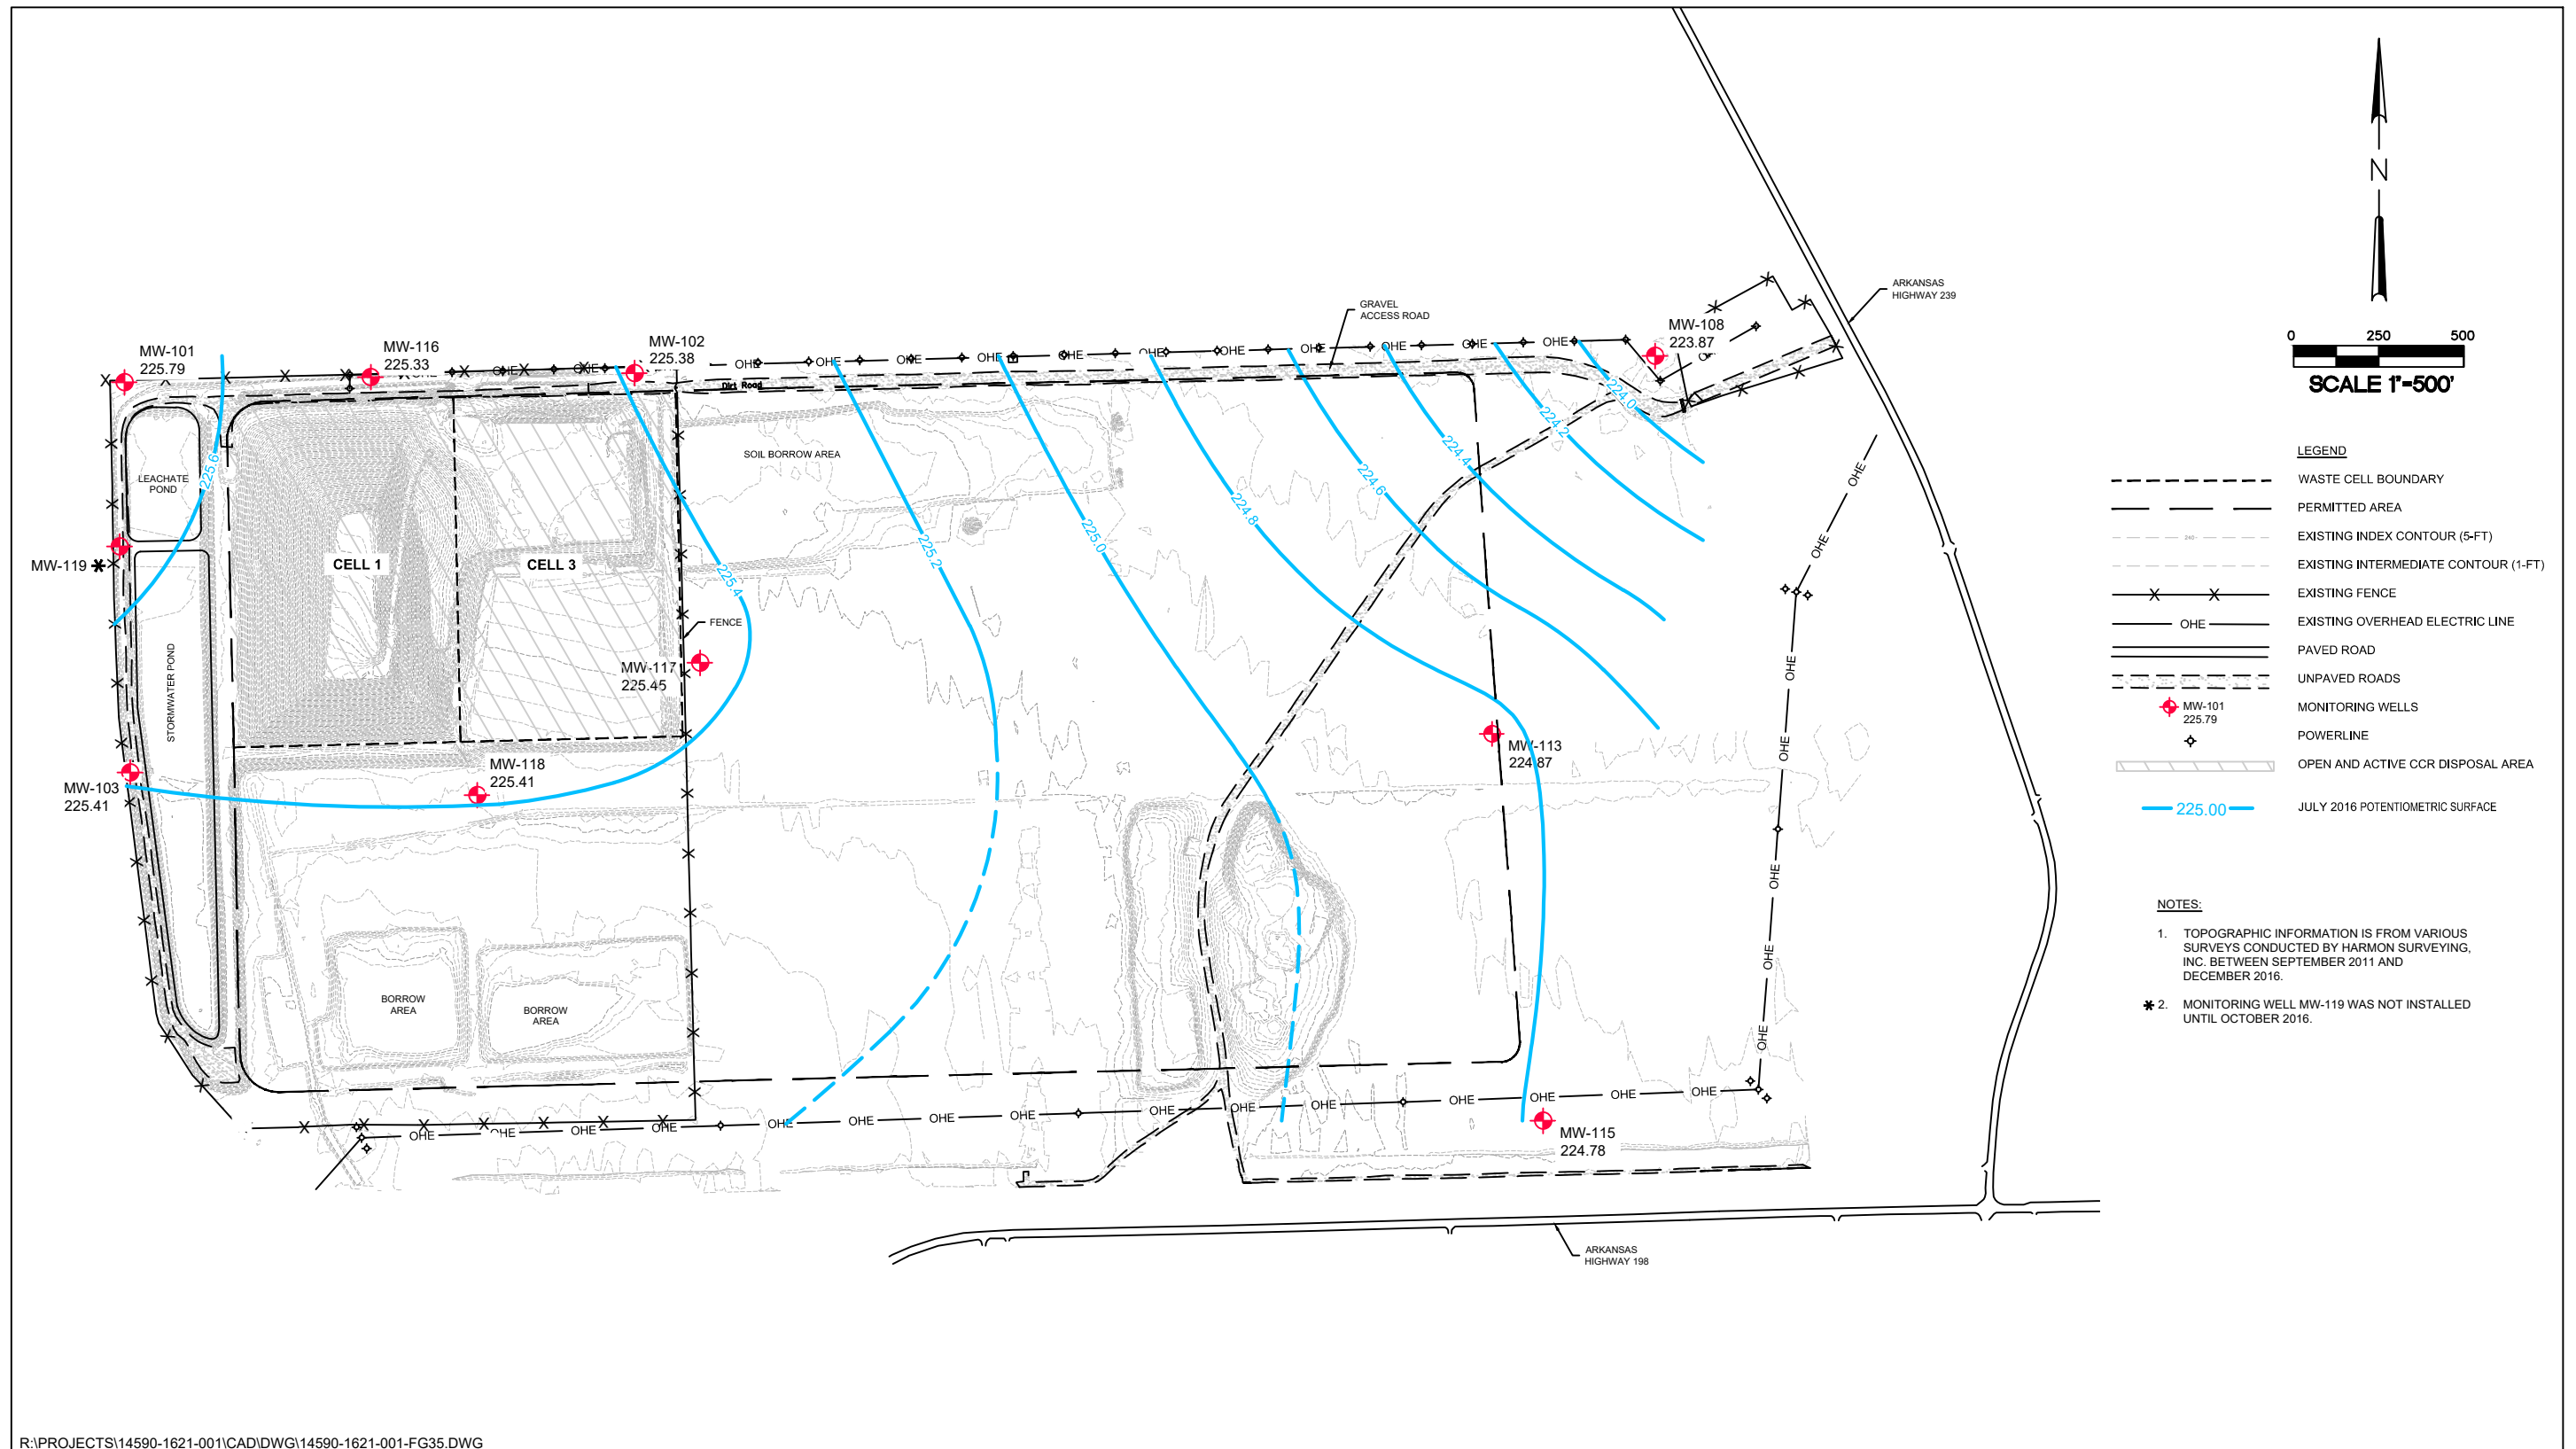


Figure 3.5. Potentiometric surface, July 2016.

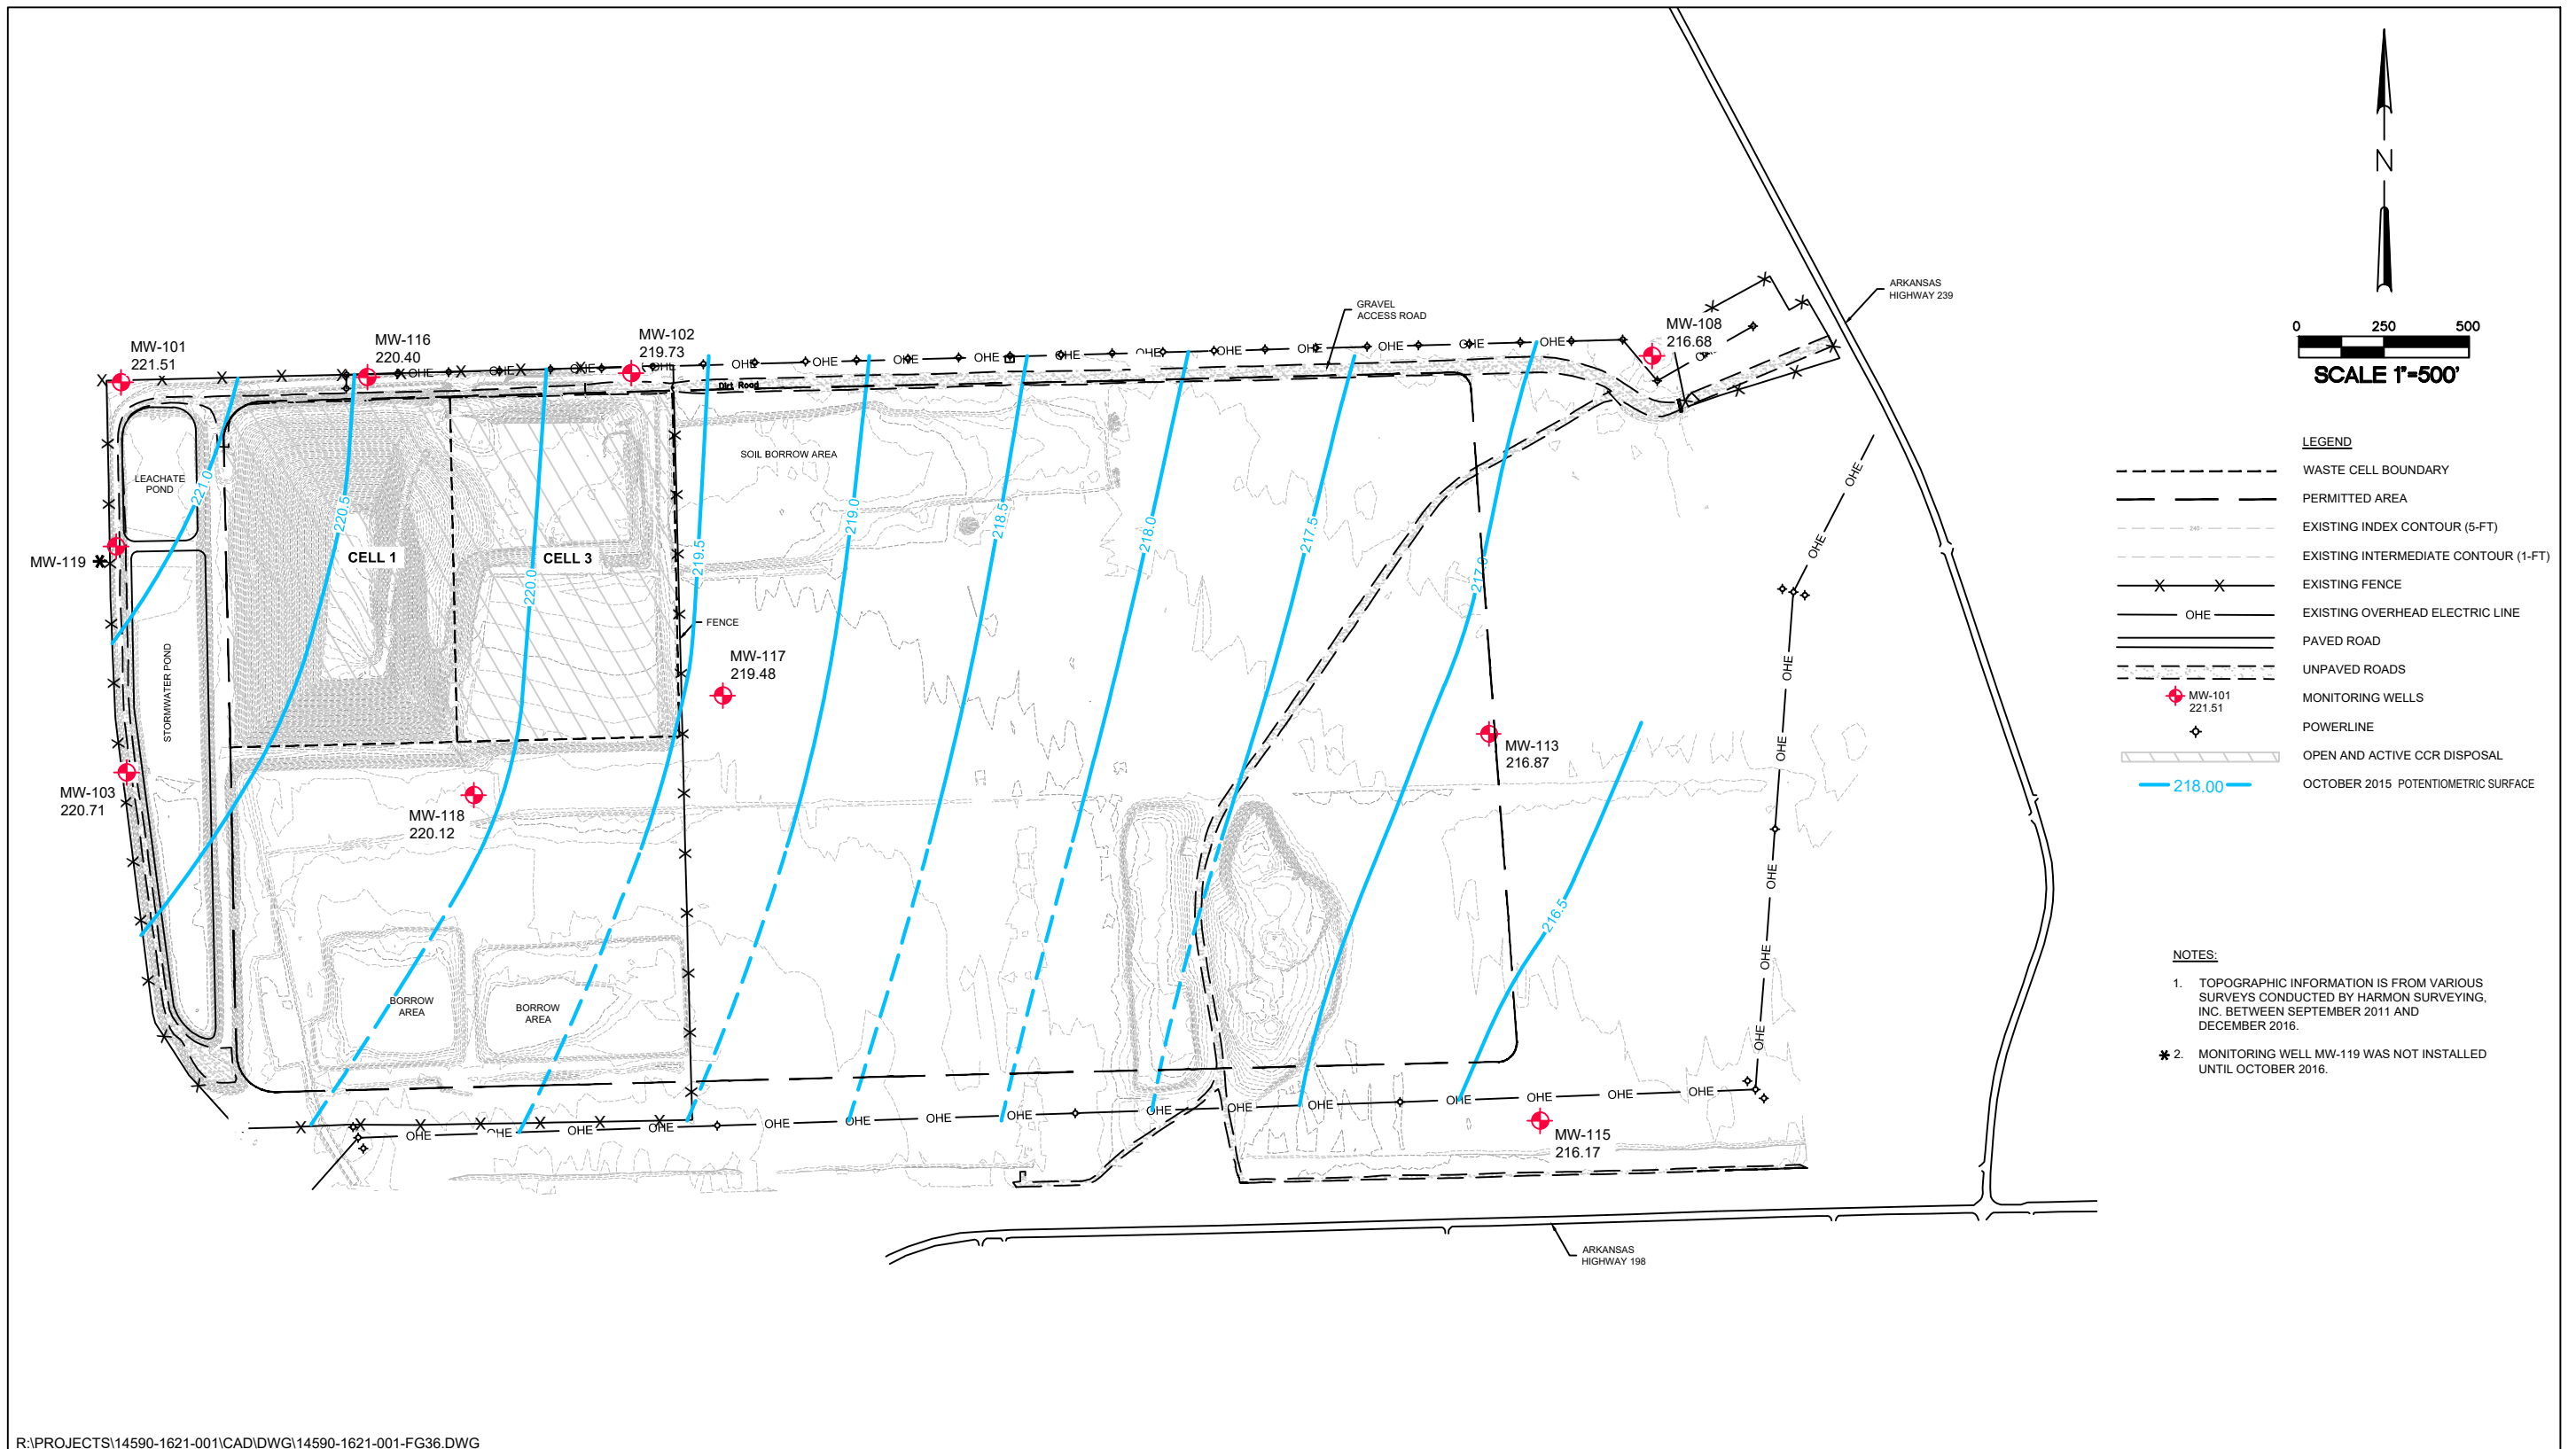


Figure 3.6. Potentiometric surface, October 2015.

As noted in the previous section, the hydraulic conductivity (K) and the effective porosity (n_e) of the alluvial aquifer are estimated to be 1.09×10^{-2} cm/sec and 27%, respectively (GEC 2001). The hydraulic gradient (dh/dl) is calculated based on potentiometric surface elevations at a given point in time. Table 3.1 summarizes the estimated dh/dl and the associated groundwater flow rate (V_x) beneath Cell 1 and Cell 3 based on the seasonal potentiometric surfaces maps included as Figures 3.3 through 3.6. These values are typical for the alluvial aquifer in the vicinity of the landfill, which has historically had a maximum observed V_x of approximately 40 ft/year.

Table 3.1. Estimated hydraulic gradient and groundwater flow rate across Cell 1 and Cell 3.

Date	Hydraulic Gradient (ft/ft)	Groundwater Velocity (ft/year)^(a)	Flow Direction
10/7/2015	9.6×10^{-4}	40	East-southeast
1/28/2016	7.2×10^{-4}	30	South-southwest
7/25/2016	2.4×10^{-4}	10	East-southeast
4/24/2017 ^(b)	3.1×10^{-4}	13	Southeast
	6.3×10^{-4}	25	Northwest

Notes:

- a. Reported to the nearest foot.
- b. Groundwater flow direction was divergent across Cell 1 and Cell 3.

4.0 REVIEW OF MONITORING NETWORK

4.1 Uppermost Aquifer and Vertical Placement of Monitoring Wells

The landfill is required by §257.91(a) to maintain a groundwater monitoring network that yields representative samples from the uppermost aquifer to ensure the detection of groundwater contamination. Based on a review of published literature and previous site investigations discussed in this report, the uppermost aquifer beneath the CCR management area is the alluvial aquifer. The well construction details provided in Appendix A show that each monitoring well is screened such that it penetrates the uppermost saturated portion of the alluvial aquifer.

The vertical position of the network's monitoring well screens in the uppermost saturated portion of the aquifer is appropriate due to the relatively low hydraulic gradient of the aquifer and the nature of the contaminants of concern (COCs) with respect to the CCR landfill. Should a release occur, each of the COCs listed in appendix III and appendix IV of the CCR Rule will either dissolve in groundwater or adsorb onto the aquifer soils. Any dissolved COCs will tend to travel at a relatively shallow elevation within the aquifer due to the low hydraulic gradient. None of the COCs are dense nonaqueous phase liquids, which tend to sink because they are more dense than water. Therefore, the target monitoring zone with respect to vertical placement is within the uppermost saturated portion of the alluvial aquifer.

The summary of well construction details provided in Table 2.1 also shows that the monitoring well screens are placed at hydrostratigraphically similar positions in the alluvial aquifer across the network. This placement is appropriate to ensure that groundwater quality data from the well network are comparable.

4.2 Location of Monitoring Wells Relative to CCR Unit

4.2.1 Monitoring Wells that Monitor Background Water Quality

As required by §257.91(c)(1), the groundwater monitoring network is required to contain a minimum of one monitoring well that is hydraulically upgradient of the CCR management area for the purpose of monitoring background water quality. However, there is not a hydraulically upgradient location at this facility because the direction of groundwater flow is seasonably

variable. As allowed by §257.91(a)(1), a facility may utilize wells for background water quality that are not hydraulically upgradient of the CCR management area. For this reason, the facility incorporated monitoring wells MW-108, MW-113, and MW-115 (Figure 2.2) to monitor background water quality because they are positioned outside the potential zone of impact from Cell 1 and Cell 3. The rationale for this is based on the age of the landfill, the estimated maximum rate of groundwater flow, and the distance of MW-108, MW-113, and MW-115 from the CCR management area. Specifically:

- MW-108, MW-113, and MW-115 are located more than 2,300 ft from the eastern edge of Cell 3,
- Groundwater at the landfill has historically exhibited a maximum flow rate of 40 ft/year, and
- The landfill became active during March 2010.

Using the information available above, a potential leachate plume would not be expected to have migrated more than 300 ft from the CCR management area as of the time of this evaluation. This estimate is conservative for the following reasons:

1. It assumes impact to groundwater occurred at the same time Cell 1 was activated and does not account for travel time through the confining unit soils;
2. It assumes that groundwater flows in one direction, but as previously discussed, groundwater flow is multidirectional and reverses flow on a seasonal basis; and
3. It does not account for any physical or chemical properties of the COCs that would cause them to travel at rates slower than groundwater (e.g., adsorption).

As such, it is expected that any potential impact would be much closer to the CCR management area as of the time of this evaluation.

The use of monitoring wells MW-108, MW-113, and MW-115 to monitor background water quality should be periodically reviewed based on the age and eastward progression of the CCR management area, measured hydraulic gradients, and estimated groundwater flow rates.

4.2.2 Downgradient Compliance Monitoring Wells

Pursuant to §257.91(c)(1), the groundwater network must include a minimum of three monitoring wells located hydraulically downgradient of the CCR management area. As shown on Figure 2.2, Cell 1 and Cell 3 are encircled by the following seven monitoring wells: MW-101, MW-102, MW-103, MW-116, MW-117, MW-118, and MW-119. Each of these wells is considered a downgradient compliance well due to the multidirectional groundwater flow at the site. As required by §257.91(c)(2), each well is horizontally positioned as close as practicable to the CCR management area to monitor the quality of groundwater passing the waste boundary of the CCR unit.

4.3 Monitoring Well Construction and Development

A review of the monitoring well installation records show that each well was installed by an Arkansas-licensed driller. As shown on the well construction details included in Appendix A, each well was constructed in a manner that maintains the integrity of the monitoring well accordance with §257.91(e). Well casings are screened and a filter pack consisting of sand was placed in the well annulus surrounding the screened intervals. The annular space above the filter pack in each well is sealed with bentonite and/or bentonite-cement grout to prevent downward migration of surface water to the sampling depth.

Monitoring well development records provided in the well installation reports referenced in Section 2.0 indicate that each monitoring well is capable of yielding samples that are representative of groundwater quality from the uppermost aquifer at the facility.

5.0 REFERENCES

- Broom, M.E., and F.P. Lyford. 1981. *Alluvial aquifer of the Cache and St. Francis River basins, northeastern Arkansas* [Open-File Report 81-476]. Little Rock, AR: Arkansas Geological Commission and US Geological Survey. 48p.
- Civil Engineering Associates, LLC. 2009. *Groundwater Monitoring Well Installation and Decommissioning Report, Dynegy Services Plum Point, LLC, Plum Point Energy Station Class 3N Landfill, Permit No. 0303-S3N, AFIN No. 47-00461* [ADEQ DIN 55427]. Jonesboro, AR: Civil Engineering Associates, LLC.
- Crone, A.J., and R.L. Wheeler. 2000. *Data for Quaternary faults, liquefaction features, and possible tectonic features in the central and eastern United States, east of the Rocky Mountain front* [Open-File Report 00-0260]. Denver: US Geological Survey, Geologic Hazards Team. 332 p.
- Counts, H.B. 1957. *Ground water resources of parts of Lonoke, Prairie, and White counties, Arkansas* [Water Resources Circular No. 5]. Little Rock, AR: Arkansas Geological Commission. 58 p.
- Cushing, E.M., E.H. Boswell, and R.L. Hosman. 1964. *General Geology of the Mississippi Embayment* [USGS Professional Paper 448-B]. Washington, DC: United States Government Printing Office. 28 p.
- Edwards Engineering, PA. 2007. *Groundwater Monitoring Well Installation and Decommissioning Report, Dynegy Services Plum Point, LLC, Plum Point Energy Station Class 3N Landfill, Permit No. 0303-S3N, AFIN No. 47-00461* [ADEQ DIN 51012]. Jonesboro, AR: Edwards Engineering, PA.
- EPA. 1986. *RCRA Ground-Water Monitoring Technical Enforcement Guidance Document* [EC-G-2002-130, EPA/530/SW-86/055]. Washington, DC: US Environmental Protection Agency, Office of Waste Programs Enforcement, Office of Solid Waste and Emergency Response. [Also published in EPA/NWWA series by National Water Well Association, Dublin, OH.] 328 pp.
- EPA. 1998. *Technical Protocol for Evaluating Natural Attenuation of Chlorinated Solvents in Ground Water* [EPA/600/R-98/128]. Washington, DC: US Environmental Protection Agency, Office of Research and Development. 248 pp.
- EPA. 2009. *Statistical Analysis of Groundwater Monitoring Data at RCRA Facilities, Unified Guidance* [EPA 530-R-09-007]. Washington, DC: Office of Resource Conservation and Recovery, Program Implementation and Information Division, US Environmental Protection Agency. March 2009.
- Ferguson, D.V., and J.L. Gray. 1971. *Soil survey of Mississippi County, Arkansas*. Washington, DC: US Department of Agriculture Soil Conservation Service in cooperation with the Arkansas Agricultural Experiment Station.
-

-
- FTN. 2015. *Monitoring Well Installation Report, Plum Point Energy Station, Class 3N Landfill, Permit No. 0303-S2N, AFIN: 47-00461* [FTN No. R14590-0943-001]. Little Rock, AR: FTN Associates, Ltd.
- FTN. 2016. *Monitoring Well Installation Report, Plum Point Energy Station Class 3N Landfill, Permit No. 0303-S2N, AFIN: 47-00461* [FTN No. R14590-1274-001]. Little Rock, AR: FTN Associates, Ltd.
- Freeze, R.A., and J.A. Cherry. 1979. *Groundwater*. Englewood Cliffs, NJ: Prentice-Hall. 604 p.
- GEC. 2001. *Geotechnical and Hydrogeological Investigation, Class 3N Solid Waste Facility, Plum Point Energy Station, Osceola, Arkansas* [ADEQ DIN 14702]. Little Rock, AR: Genesis Environmental Consulting, Inc.
- Gibbons, R.D. 1994. *Statistical Methods for Groundwater Monitoring*. New York: John Wiley & Sons, Inc.
- Gonthier, G.J. 2003. *Quality of Groundwater in Pleistocene and Holocene Subunits of the Mississippi River Alluvial Aquifer, 1998* [Water-Resources Investigations Report 2003 4202]. Jackson, MS: National Water-Quality Assessment Program, US Geological Survey.
- Holland, T.W. 2004. *Estimated water use in Arkansas, 2000* [USGS Scientific Investigations Report 2004-5230]. Reston, VA: US Geological Survey in cooperation with the Arkansas Soil and Water Conservation Commission. 31 p.
- Hosman, R.L., A.T. Long, T.W. Lambert, et al. 1968. *Tertiary aquifers in the Mississippi embayment* [USGS Professional Paper 448-D]. Washington, DC: United States Government Printing Office. 29p.
- Kresse, T.M., P.D. Hays, K.R. Merriman, J.A. Gillip, D.T. Fugitt, J.L. Spellman, A.M. Nottmeier, D.A. Westerman, J.M. Blackstock, and J.L. Battreal. 2014. *Aquifers of Arkansas—Protection, management, and hydrologic and geochemical characteristics of groundwater resources in Arkansas* [Scientific Investigations Report 2014–5149]. Prepared in cooperation with the Arkansas Natural Resources Commission. Reston, VA: US Geological Survey. 334 pp. doi: <http://dx.doi.org/10.3133/sir20145149>.
- Kuo, J. 2015. *Practical design calculations for groundwater and soil remediation*. Boca Raton, FL: Lewis Publishers.
- Peterson, J.C., M.E. Broom, and W.V. Bush. 1985. *Geohydrologic units of the Gulf Coastal Plain in Arkansas* [USGS Water Resources Investigations Report 85-4116]. Little Rock, AR: US Geological Survey in cooperation with the Arkansas Department of Pollution Control and Ecology and the Arkansas Geological Commission. 20 p.
- Pugh, A.L., P.W. Westerfield, and D.T. Poynter. 1997. *Thickness of the Quaternary alluvial and terrace deposits comprising the Mississippi River Valley alluvial aquifer in eastern Arkansas* [USGS Water Resources Investigations Report 97-4049]. Little Rock, AR: US Geological Survey in cooperation with the Arkansas Geological Commission. 1 plate.
-

- Ryling, R.W. 1960. *Ground-water potential of Mississippi County, Arkansas* [Water Resources Circular No. 7]. Little Rock, AR: Arkansas Geological and Conservation Commission in cooperation with the US Geological Survey. 87 p.
- Schrader, T.P. 2015. *Water levels and water quality in the Mississippi River Valley alluvial aquifer in eastern Arkansas, 2012* [Scientific Investigations Report 2015-5059]. Prepared in cooperation with the Arkansas Natural Resources Commission and the Arkansas Geological Survey. Reston, VA: US Geological Survey.
- US Army Corps of Engineers. [no date]. "Station information for Mississippi River H.W. Gage 152 Near Osceola, AR (South)" (web page). Accessed September 2017 at <http://rivergages.mvr.usace.army.mil/WaterControl/stationinfo2.cfm?sid=MS121&fid=&dt=S>
- US Department of Agriculture. 2012. *2012 census of agriculture – county data, Arkansas*. Washington, DC: US Department of Agriculture, National Agricultural Statistics Service. Available online at https://www.agcensus.usda.gov/Publications/2012/Full_Report/Volume_1,_Chapter_2_County_Level/Arkansas/st05_2_001_001.pdf
- Welch, H.L., J.A. Kingsbury, W.T. Roland, and R.C. Seanor. 2009. *Quality of shallow groundwater and drinking water in the Mississippi Embayment-Texas Coastal Uplands aquifer system and the Mississippi River Valley alluvial aquifer, south-central United States, 1994-2004* [Scientific Investigations Report 2009-5091]. Reston, VA: National Water-Quality Assessment Program, US Geological Survey.
- Yu, C., S. Kamboj, C. Wang, and J. Cheng. 2015. *Data collection handbook to support modeling impacts of radioactive material in soil and building structures* [ANL/EVS/TM-14/4]. Argonne, IL: US Department of Energy, Argonne National Laboratory, Environmental Science Division.

APPENDIX A

Boring Logs and Monitoring Well Construction Diagrams

GEC

GENESIS ENVIRONMENTAL CONSULTING, INC.

11400 West Baseline Road

Little Rock, AR 72209

Phone: (501) 455-2199

Fax (501) 455-4547

FIELD BOREHOLE LOGBOREHOLE NO.: **MW-101** TOTAL DEPTH: 30'COORDINATES: **489496.27N 1915916.93E**ELEVATION: TOC ELEVATION: **242.75 ft****PROJECT INFORMATION****DRILLING INFORMATION**PROJECT: **Plum Point Energy Station**DRILLING CO.: **Anderson Engineering**SITE LOCATION: **Osceola, AR**DRILLER: **Paul Harris**JOB NO.: **01008**RIG TYPE: **Simco 2400 SKL**LOGGED BY: **ME**METHOD OF DRILLING: **6.25" diam. Solid flight auger**DATE DRILLED: **4/09/01**SAMPLING METHODS: **Split Spoon**

GRAVEL PACK: 10-20 Sand

SEAL: Bentonite pellets

GROUT: Bentonite chips

Page 1 of 1

CASING/SCREEN TYPE: PVC

DIAMETER: 2-inch

CASING LENGTH: 23.63

STATIC WATER LEVEL: 21.53' BELOW TOC


SCREEN LENGTH: 10'

SLOT SIZE: 0.010

T.D. OF WELL 33.63' BELOW TOC

DATE OF WATER LEVEL: 5/02/01

DEPTH	SOIL SYMBOL	SOIL DESCRIPTION	BLOW COUNTS	COMMENTS	BORING COMPLETION	WELL DESCRIPTION
-------	-------------	------------------	-------------	----------	-------------------	------------------

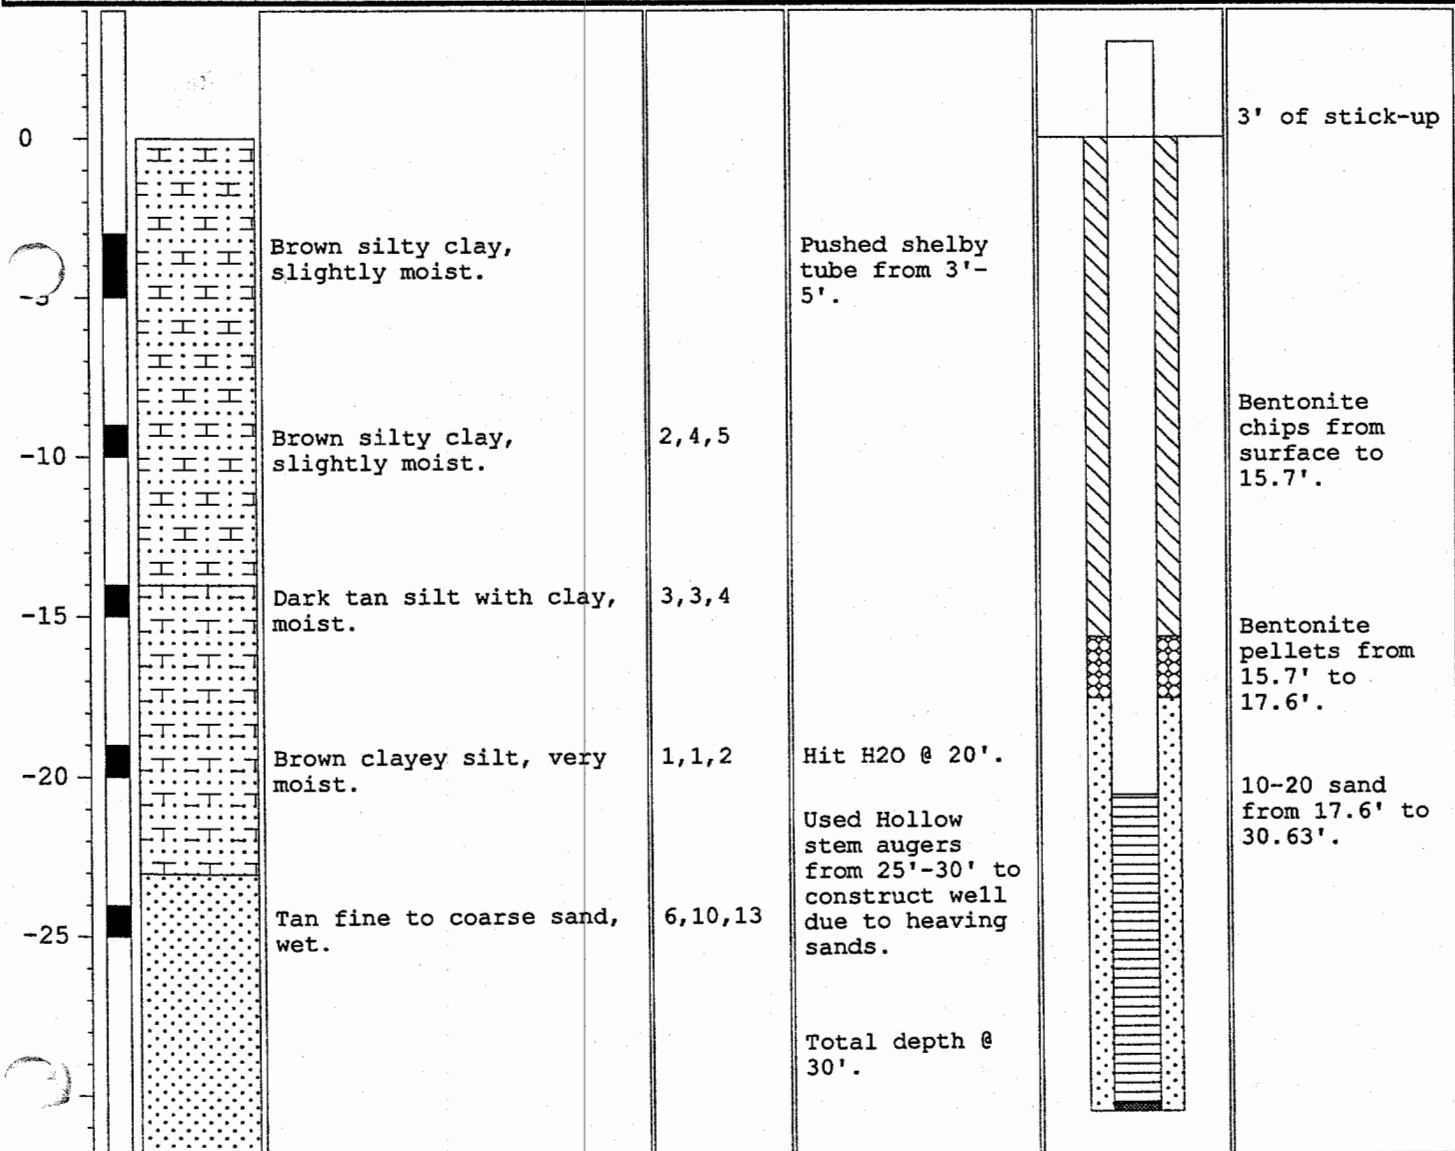

Borehole and/or well IDs were updated to reflect the nomenclature used for the EPA CCR Rule network. Vertical and horizontal coordinates were updated based on survey report dated November 18, 2016. Vertical datum is based on NAVD88 and horizontal datum is based on Arkansas State Plane NAD83 North.



GENESIS ENVIRONMENTAL CONSULTING, INC.

11400 West Baseline Road
Phone: (501) 455-2199

Little Rock, AR 72209
Fax (501) 455-4547

FIELD BOREHOLE LOG

BOREHOLE NO.: **MW-102** TOTAL DEPTH: 30'

COORDINATES: **489523.55N 1917416.25E**

ELEVATION: TOC ELEVATION: **243.99 ft**

PROJECT INFORMATION

DRILLING INFORMATION

PROJECT: **Plum Point Energy Station**

DRILLING CO.: **Anderson Engineering**

SITE LOCATION: **Osceola, AR**

DRILLER: **Paul Harris**

JOB NO.: **01008**

RIG TYPE: **Simco 2400 SKL**

LOGGED BY: **ME**

METHOD OF DRILLING: **6.25" diam. solid flight auger**

DATE DRILLED: **4/09/01**

SAMPLING METHODS: **Split Spoon**

GRAVEL PACK: 10-20 Sand

SEAL: Bentonite pellets

GROUT: Bentonite chips

Page 1 of 1

CASING/SCREEN TYPE: PVC

DIAMETER: 2-inch

CASING LENGTH: 20.23'

STATIC WATER LEVEL: 22.13' BELOW TOC

SCREEN LENGTH: 10'

SLOT SIZE: 0.010

T.D. OF WELL 30.23' BELOW TOC

DATE OF WATER LEVEL: 5/02/01

DEPTH	SOIL SYMBOL	SOIL DESCRIPTION	BLOW COUNTS	COMMENTS	BORING COMPLETION	WELL DESCRIPTION
0						3' of stick-up
-5		Brown and gray silty clay, slightly moist, medium plasticity.	1,1,2	Pushed shelby tube from 3'-5'.		Bentonite chips from surface to 12'.
-10		Brown and gray silty clay, slightly moist, medium plasticity.	3,3,6			Bentonite pellets from 12' to 14'.
-15		Dark brown to gray silty clay, moist.	2,2,3			
-20		Dark brown to gray silty clay, with fine to medium grained sand, wet.	3,4,6	Hit H2O @ 20'.		10-20 sand from 14' to 27'.
-25		Dark brown to gray silty clay, with increasing fine to medium sand, wet.		Hollow stem augers used to construct well due to heaving sands from 25'-30'.		
-30		Tan to brown fine to medium grained sand with some silt, wet.		Total depth @ 30'.		

Borehole and/or well IDs were updated to reflect the nomenclature used for the EPA CCR Rule network. Vertical and horizontal coordinates were updated based on survey report dated November 18, 2016. Vertical datum is based on NAVD88 and horizontal datum is based on Arkansas State Plane NAD83 North.



FIELD BORING LOG

BORING NO.: **MW-103**

PAGE: 1 of 1

TOTAL DEPTH: 30' FEET BELOW GROUND SURFACE (BGS)

CLIENT: Dynegey Services Plum Point, LLC

PROJECT: Plum Point Well Installation

JOB NO.: LSP-AR-PPES-07-02

DRILLING CO.: Anderson Engineering

LOGGED BY: Lance Powell

DRILLER: Dennis Young

DATE DRILLED: 9-26-07

RIG TYPE: Simco 2800 HS (HT)

DRILLING METHOD: Hollow Stem Auger


SAMPLING METHOD: Split Spoon




Depth BGS	Sample Interval	488350.05N	1915934.03E	TOC: 243.25 ft	Litho. Symbol	Blow Counts	Comments
		DESCRIPTION					
0		Topsoil 0' - 0.5' Dark Brown Silty Clay					
5		Gray to Brown Silty Clay, trace organics, Moist				1,2,2	
10		Gray Clay, Medium to High Plasticity Some Silt, Moist				1,2,4	
15		Gray Clay, Medium to High Plasticity Some Silt, Moist				2,5,4	
20		Gray , Medium to Coarse Sand, Some Clay, Wet, Grading into Silty Sand				1,1,2	Contact with medium to coarse sand at 16' Hit water at 20' ▽
25		Gray , Sandy Silt, Wet					Split Spoon samples not taken at 25' and 30' due to heaving sands
		Gray , Silty, Coarse Sand, Some Clay, Wet					

Borehole and/or well IDs were updated to reflect the nomenclature used for the EPA CCR Rule network. Vertical and horizontal coordinates were updated based on survey report dated November 18, 2016. Vertical datum is based on NAVD88 and horizontal datum is based on Arkansas State Plane NAD83 North.

MONITORING WELL INSTALLATION RECORD

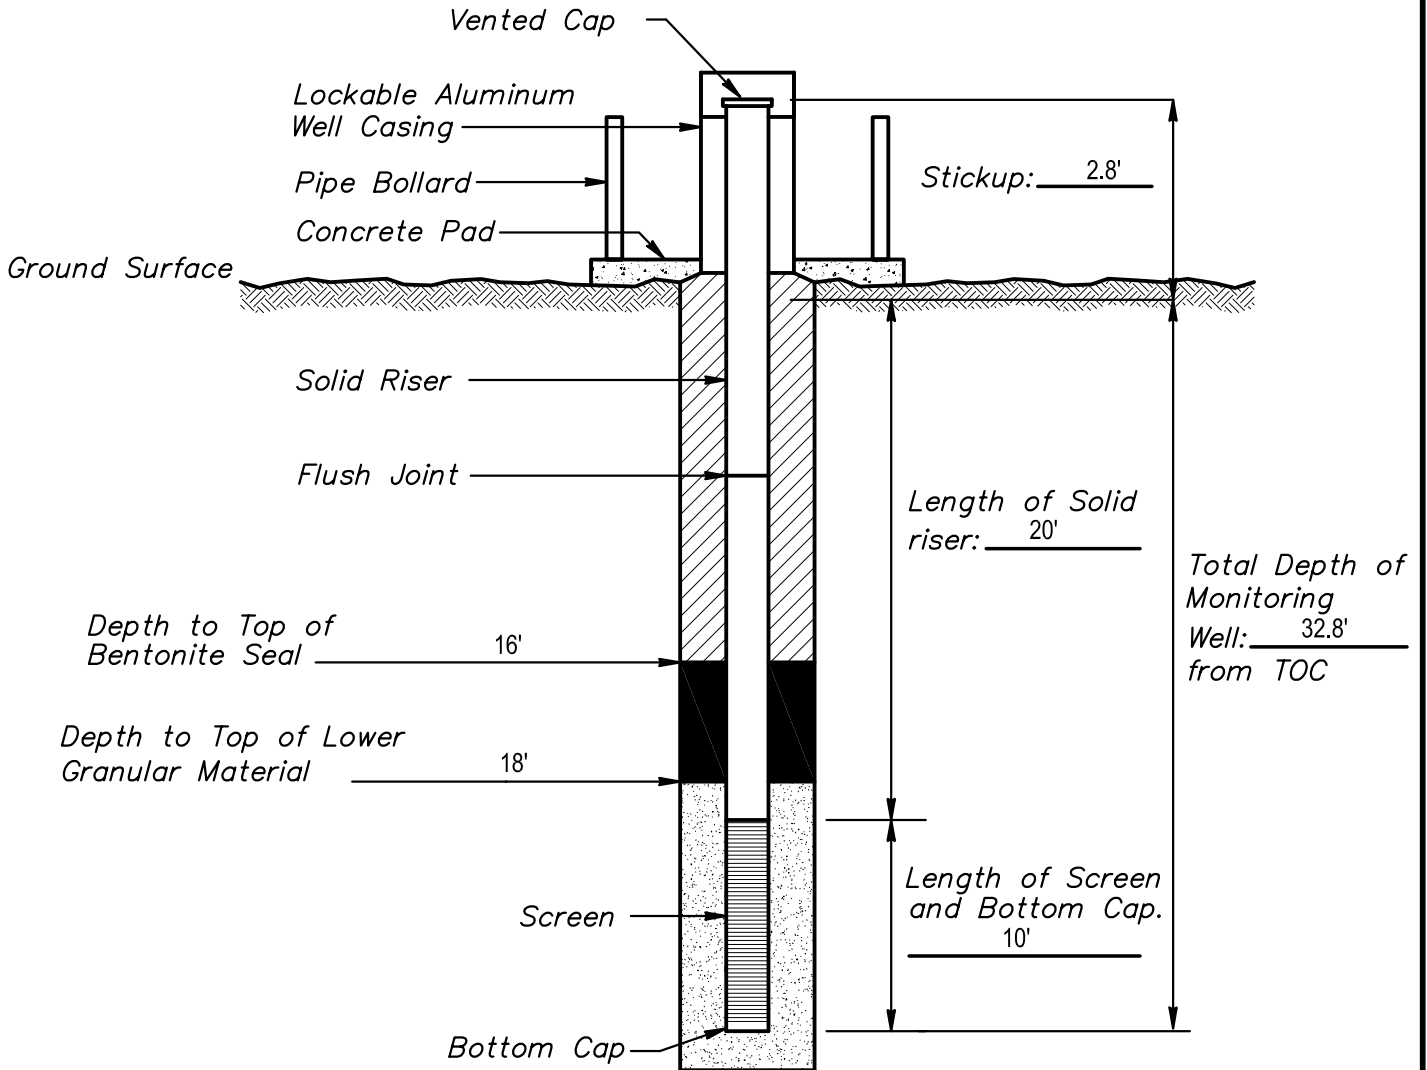Job Name Plum Point Energy Well Station Well Number MW-103
 Job Number LSP-AR-PPES-07-02 Installation Date September 26, 2007 Location PPES Class 3N Landfill
 Datum Elevation 243.25 ft Surface Elevation 240.5 ft
 Datum for Water Level Measurement Top of PVC Stickup
 Screen Diameter & Material 2" PVC Slot Size 0.010"
 Riser Diameter & Material 2" PVC Borehole Diameter 7.25"
 Granular Backfill Material Sand Representative Phillip Fields
 Drilling Method Hollow Stem Auger Drilling Contractor Anderson Engineering



-  Bentonite Pellets
-  Bentonite Plug
-  Granular Backfill

(Not to Scale)

Stabilized water level 22.15 feet below datum.

Measured on September 27, 2007



EDWARDS ENGINEERING, P.A.
Civil and Environmental Engineering, Planning, and Consulting

MONITORING WELL INSTALLATION RECORD

PROJECT NUMBER: LSP-AR-PPES-07-02

WELL NUMBER: MW-3R

DRAWING NUMBER: 1

CHECKED BY: LP

GEC

GENESIS ENVIRONMENTAL CONSULTING, INC.

11400 West Baseline Road
Phone: (501) 455-2199Little Rock, AR 72209
Fax (501) 455-4547**FIELD BOREHOLE LOG**BOREHOLE NO.: **MW-108** TOTAL DEPTH: **30'**COORDINATES: **489573.87N 1920414.52E**ELEVATION: TOC ELEVATION: **245.11 ft****PROJECT INFORMATION****DRILLING INFORMATION**PROJECT: **Plum Point Energy Station**DRILLING CO.: **Anderson Engineering**SITE LOCATION: **Osceola, AR**DRILLER: **Paul Harris**JOB NO.: **01008**RIG TYPE: **Simco 2400 SKL**LOGGED BY: **ME**METHOD OF DRILLING: **6.25" diam. solid flight auger**DATE DRILLED: **4/11/01**SAMPLING METHODS: **Split Spoon**

GRAVEL PACK: 10-20 Sand

SEAL: Bentonite pellets

GROUT: Bentonite chips

Page 1 of 1

CASING/SCREEN TYPE: PVC

DIAMETER: 2-inch

CASING LENGTH: 22.40'

STATIC WATER LEVEL: 22.54' BELOW TOC


SCREEN LENGTH: 10'

SLOT SIZE: 0.010

T.D. OF WELL 32.40' BELOW TOC

DATE OF WATER LEVEL: 5/02/01

DEPTH	SOIL SYMBOL	SOIL DESCRIPTION	BLOW COUNTS	COMMENTS	BORING COMPLETION	WELL DESCRIPTION
-------	-------------	------------------	-------------	----------	-------------------	------------------

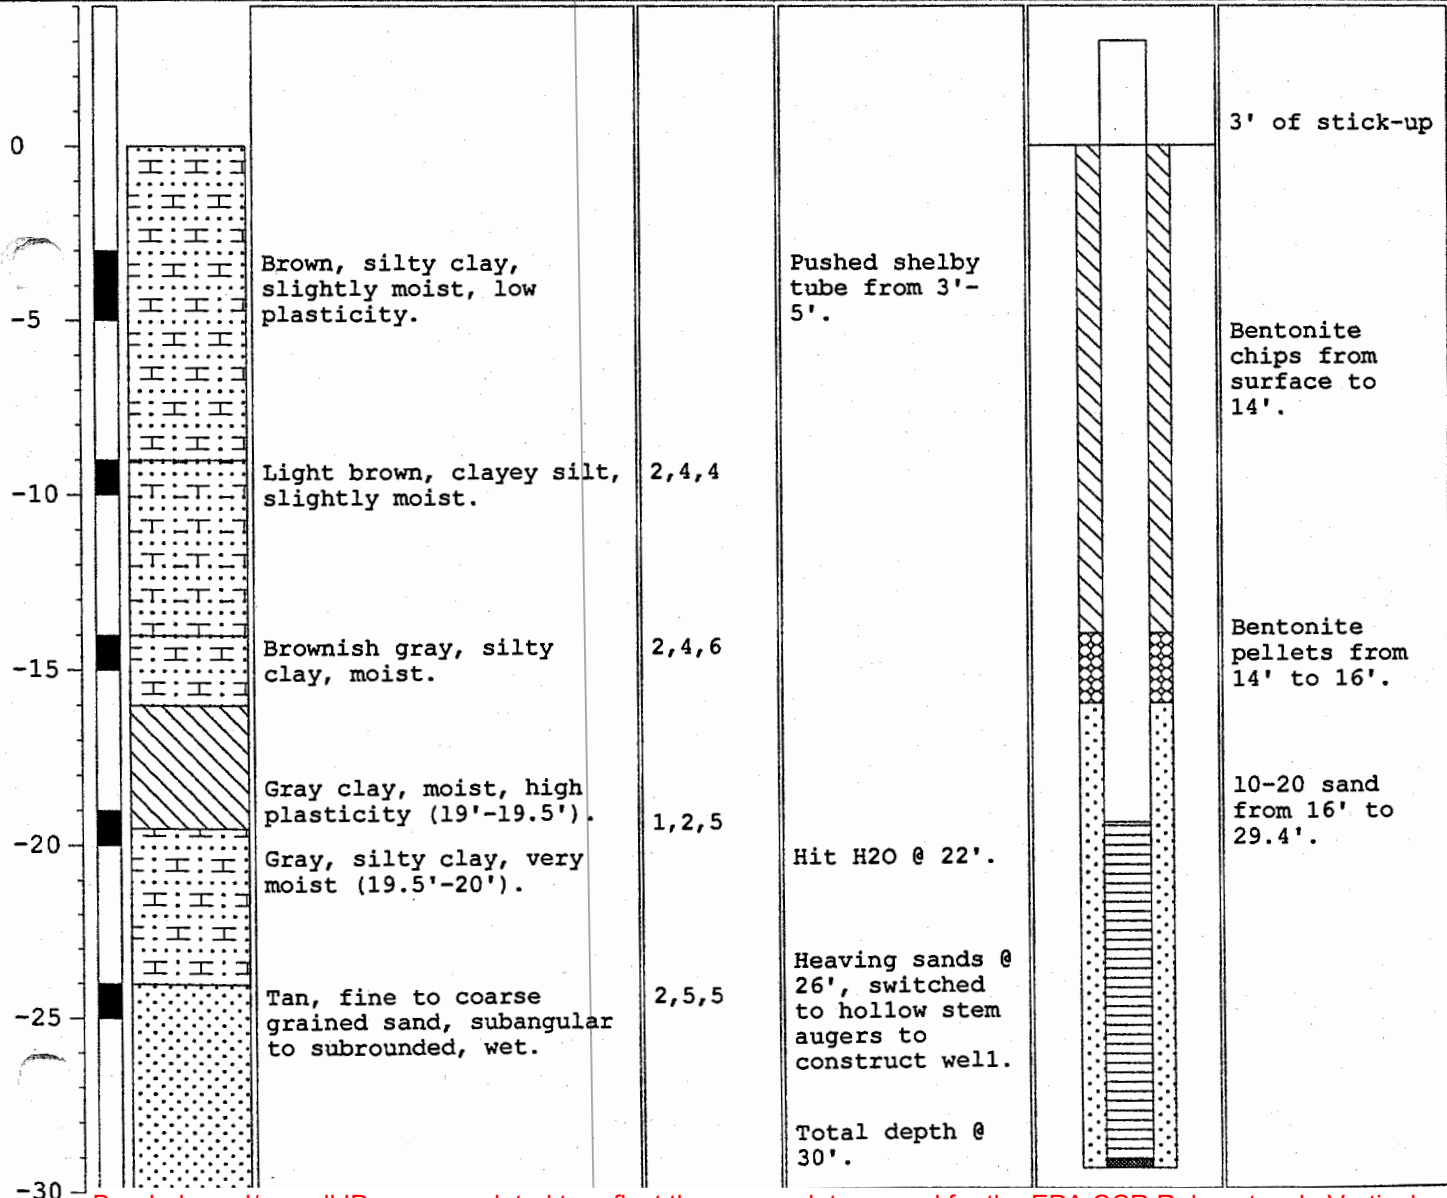

Borehole and/or well IDs were updated to reflect the nomenclature used for the EPA CCR Rule network. Vertical and horizontal coordinates were updated based on survey report dated November 18, 2016. Vertical datum is based on NAVD88 and horizontal datum is based on Arkansas State Plane NAD83 North.



CIVIL ENGINEERING ASSOCIATES, LLC
 CONSULTING • DESIGN • TESTING • INVESTIGATION

FIELD BORING LOG

BORING NO.: MW-113

PAGE: 1 of 1

TOTAL DEPTH: 33' FEET BELOW GROUND SURFACE (BGS)

CLIENT: Dynegey Services Plum Point, LLC

PROJECT: Plum Point MW-13 Replacement

JOB NO.: DY-09-02

DRILLING CO.: Tri-State Testing Services, Inc.

LOGGED BY: Lance Powell








DRILLER: Mike Woolfolk

DATE DRILLED: 4/7/09

RIG TYPE: CME 55


DRILLING METHOD: Hollow Stem Auger

SAMPLING METHOD: Continuous

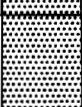Depth BGS	Sample Interval	488463.15N	1919936.06E	TOC: 244.63 ft	Litho. Symbol	Comments
DESCRIPTION						
0						
						
						Topsoil 0' - 0.5' Dark Brown Silty Clay
						Gray to Brown Silty Clay, Moist, Trace Organics
5						
						Tan to Brown Silty Sand, Fine to Medium grain, Moist
10						
						Tan, Medium to Coarse Grain Sand, Subangular to Subrounded, Damp
15						
						Tan, Medium to Coarse Grain Sand, Subangular to Subrounded, Damp
						Hit water at 18' ∇
20						
						Tan, Fine to Medium Grain Sand with Trace Brown Clay, Subangular to Subrounded, Wet
25						
						Tan, Fine to Coarse Grain Sand, Subangular to Subrounded, Wet
30						
						Over 15' of wet sand. Auger started to lock up. Sample not taken at 33.


MONITORING WELL INSTALLATION RECORD

Job Name Plum Point Energy Station MW-13 Replacement Well Number MW-113
 Job Number DY-09-02 Installation Date 4/7/09 Location PPES Class 3N Landfill
 Datum Elevation 244.63 ft Surface Elevation 241.5 ft
 Datum for Water Level Measurement Top of PVC Stickup
 Screen Diameter & Material 2" PVC Slot Size 0.010"
 Riser Diameter & Material 2" PVC Borehole Diameter 7 1/4"
 Granular Backfill Material Sand Representative Lance Powell
 Drilling Method Hollow Stem Auger Drilling Contractor Tri-State Testing Services, Inc.

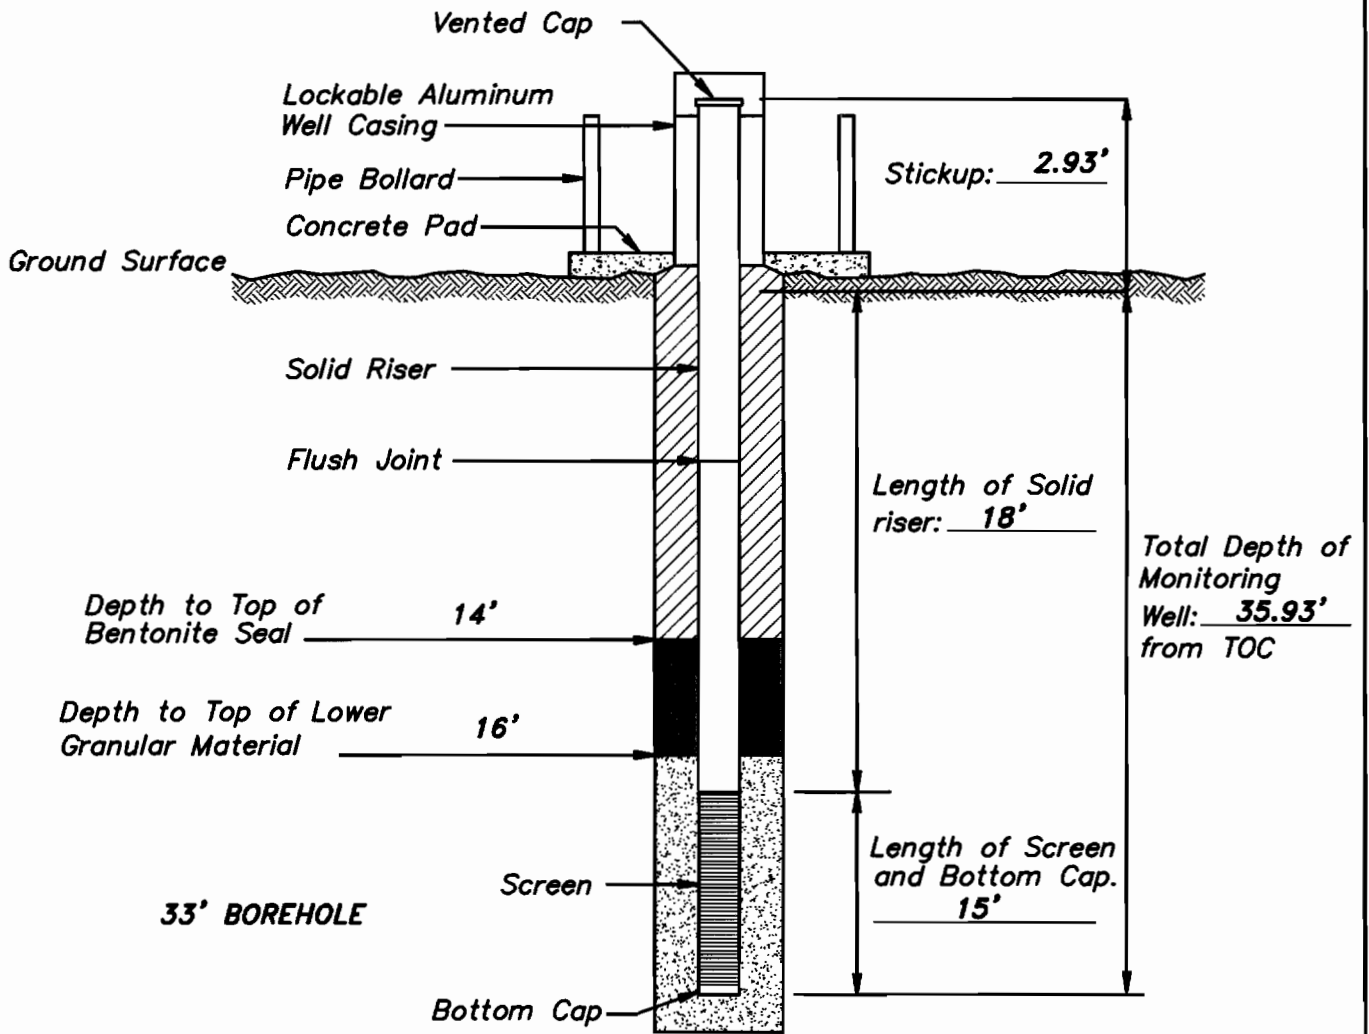

- Bentonite Pellets
- Bentonite Plug
- Granular Backfill

(Not to Scale) Stabilized water level 18.07 feet below datum.
 Measured on 4-09-09

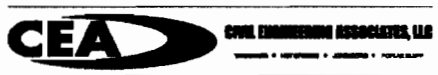


MONITORING WELL INSTALLATION RECORD




PROJECT NUMBER: DY-09-02
 WELL NUMBER: MW-13R
 DRAWING NUMBER: 1 CHECKED BY: LP

Borehole and/or well IDs were updated to reflect the nomenclature used for the EPA CCR Rule network. Vertical and horizontal coordinates were updated based on survey report dated November 18, 2016. Vertical datum is based on NAVD88 and horizontal datum is based on Arkansas State Plane NAD83 North.

MONITORING WELL INSTALLATION RECORD

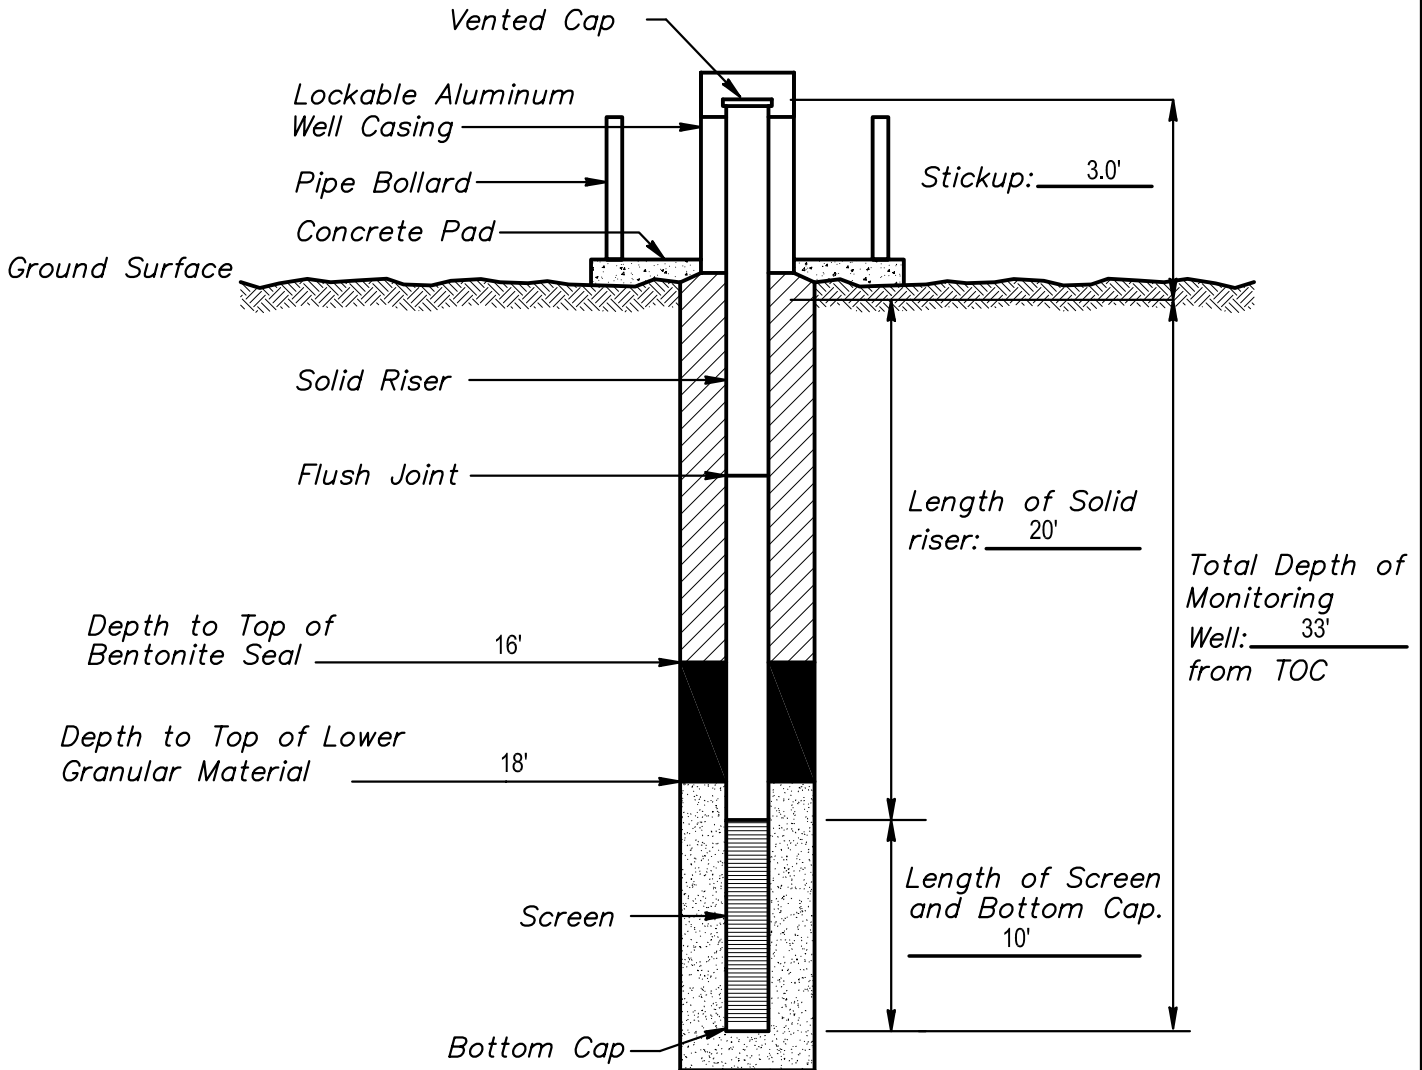Job Name Plum Point Energy Well Station Well Number MW-115
 Job Number LSP-AR-PPES-07-02 Installation Date September 25, 2007 Location PPES Class 3N Landfill
 Datum Elevation 243.55 ft Surface Elevation 240.4 ft
 Datum for Water Level Measurement Top of PVC Stickup
 Screen Diameter & Material 2" PVC Slot Size 0.010"
 Riser Diameter & Material 2" PVC Borehole Diameter 7.25"
 Granular Backfill Material Sand Representative Phillip Fields
 Drilling Method Hollow Stem Auger Drilling Contractor Anderson Engineering



-  Bentonite Pellets
-  Bentonite Plug
-  Granular Backfill

(Not to Scale)

Stabilized water level 27.01 feet below datum.

Measured on September 27, 2007



EDWARDS ENGINEERING, P.A.
Civil and Environmental Engineering, Planning, and Consulting

MONITORING WELL INSTALLATION RECORD

PROJECT NUMBER: LSP-AR-PPES-07-02


WELL NUMBER: MW-15

DRAWING NUMBER: 5

CHECKED BY: LP




PROJECT: Plum Point Energy Station Landfill		BORING ID: MW-116	
LOCATION: Osceola, AR		WELL ID: MW-116	
DRILLING CONTRACTOR: McCray Drilling Inc		NORTHING: 489511.74	EASTING: 1916640.87
DRILLING EQUIPMENT: CME 750X		GROUND SURFACE ELEV.: 239.3 ft	TOC ELEVATION: 243.97 ft
DRILLING METHOD: 8.5" H.S.A.		TOTAL DEPTH: 31.9 ft below TOC	DEPTH TO WATER: 17 ft bgs
LOGGED BY: DLD	SAMPLING METHOD: 5-ft split barrel	DATE STARTED: 6/23/2015	DATE COMPLETED: 6/23/2015

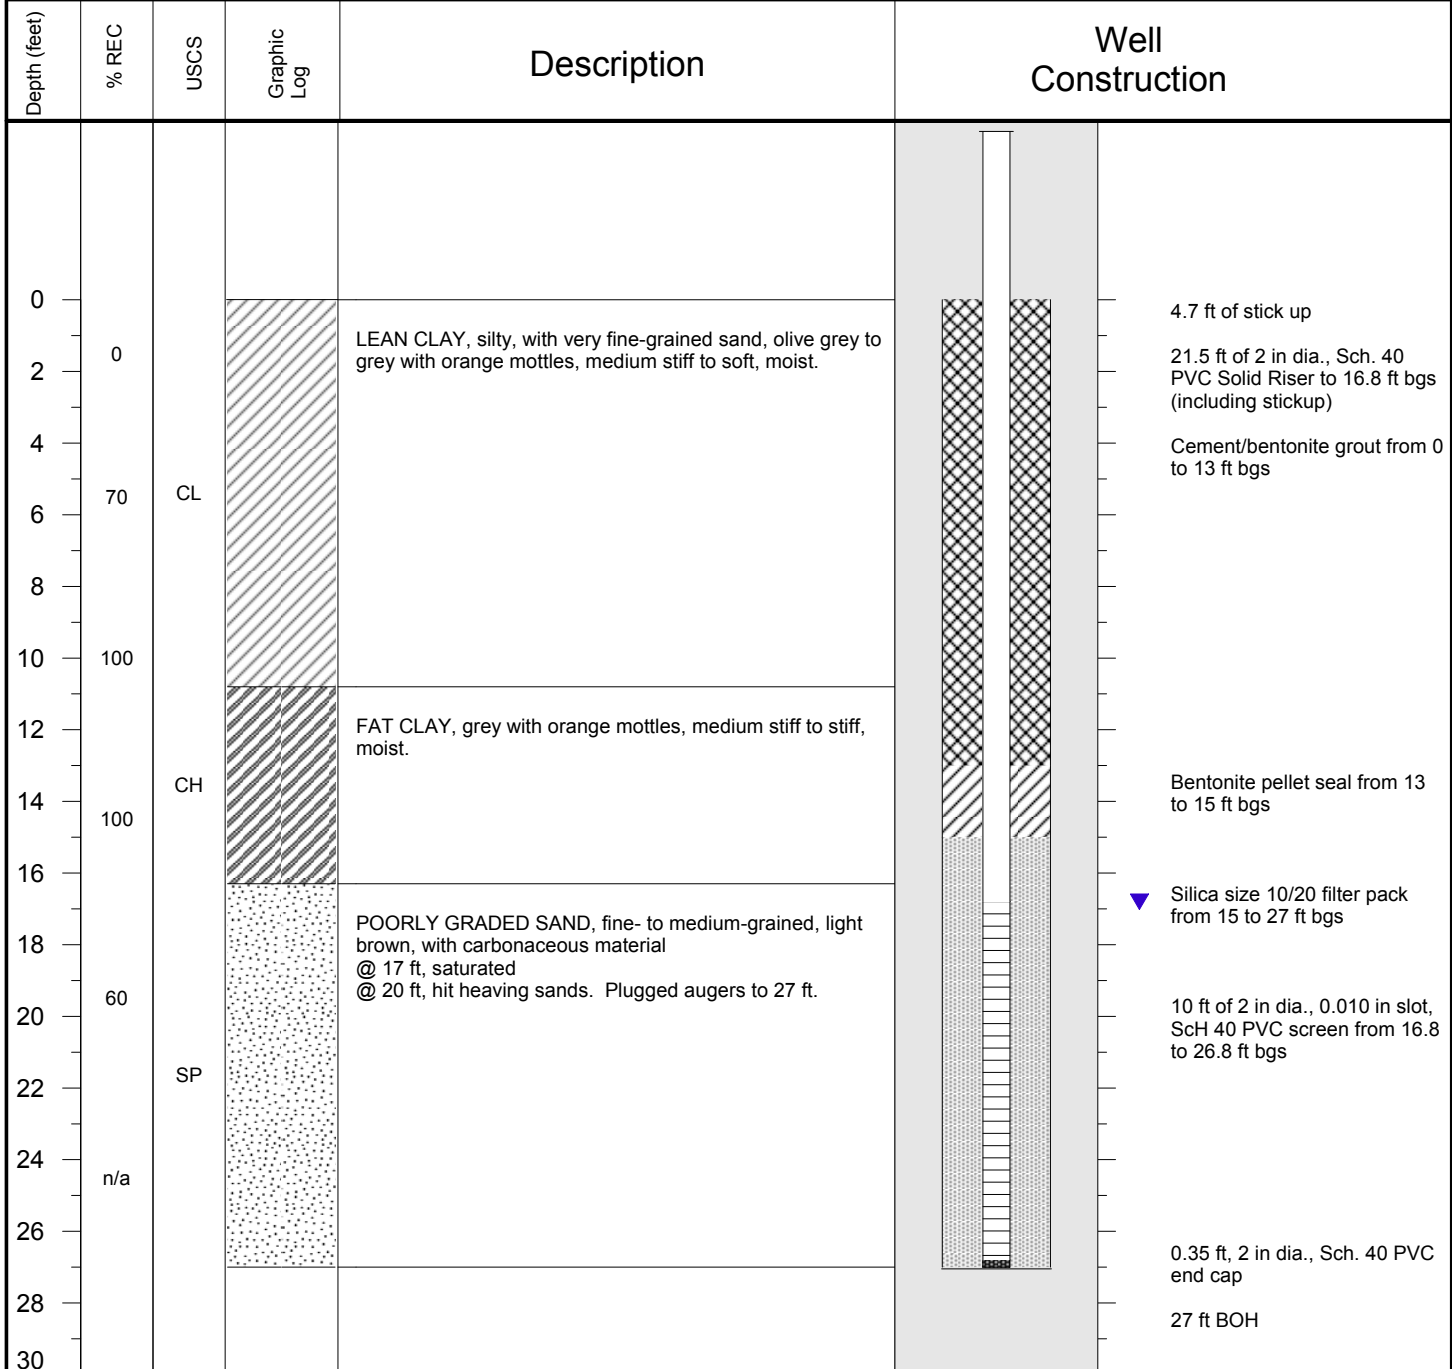

NOTES: Borehole and/or well IDs were updated to reflect the nomenclature used for the EPA CCR Rule network. Vertical and horizontal coordinates were updated based on survey report dated July 29, 2015. Horizontal and vertical coordinates are based on Arkansas State Plane NAD83 North Coordinates and NAVD88.




PROJECT: Plum Point Energy Station Landfill	BORING ID: MW-117	
LOCATION: Osceola, AR	WELL ID: MW-117	
DRILLING CONTRACTOR: McCray Drilling Inc	NORTHING: 488672.25	EASTING: 1917608.53
DRILLING EQUIPMENT: CME 750X	GROUND SURFACE ELEV.: 239.4 ft	TOC ELEVATION: 242.53 ft
DRILLING METHOD: 8.5" H.S.A.	TOTAL DEPTH: 34.1 ft below TOC	DEPTH TO WATER: 17 ft bgs
LOGGED BY: DLD	SAMPLING METHOD: 5-ft split barrel	DATE STARTED: 6/24/2015
		DATE COMPLETED: 6/24/2015

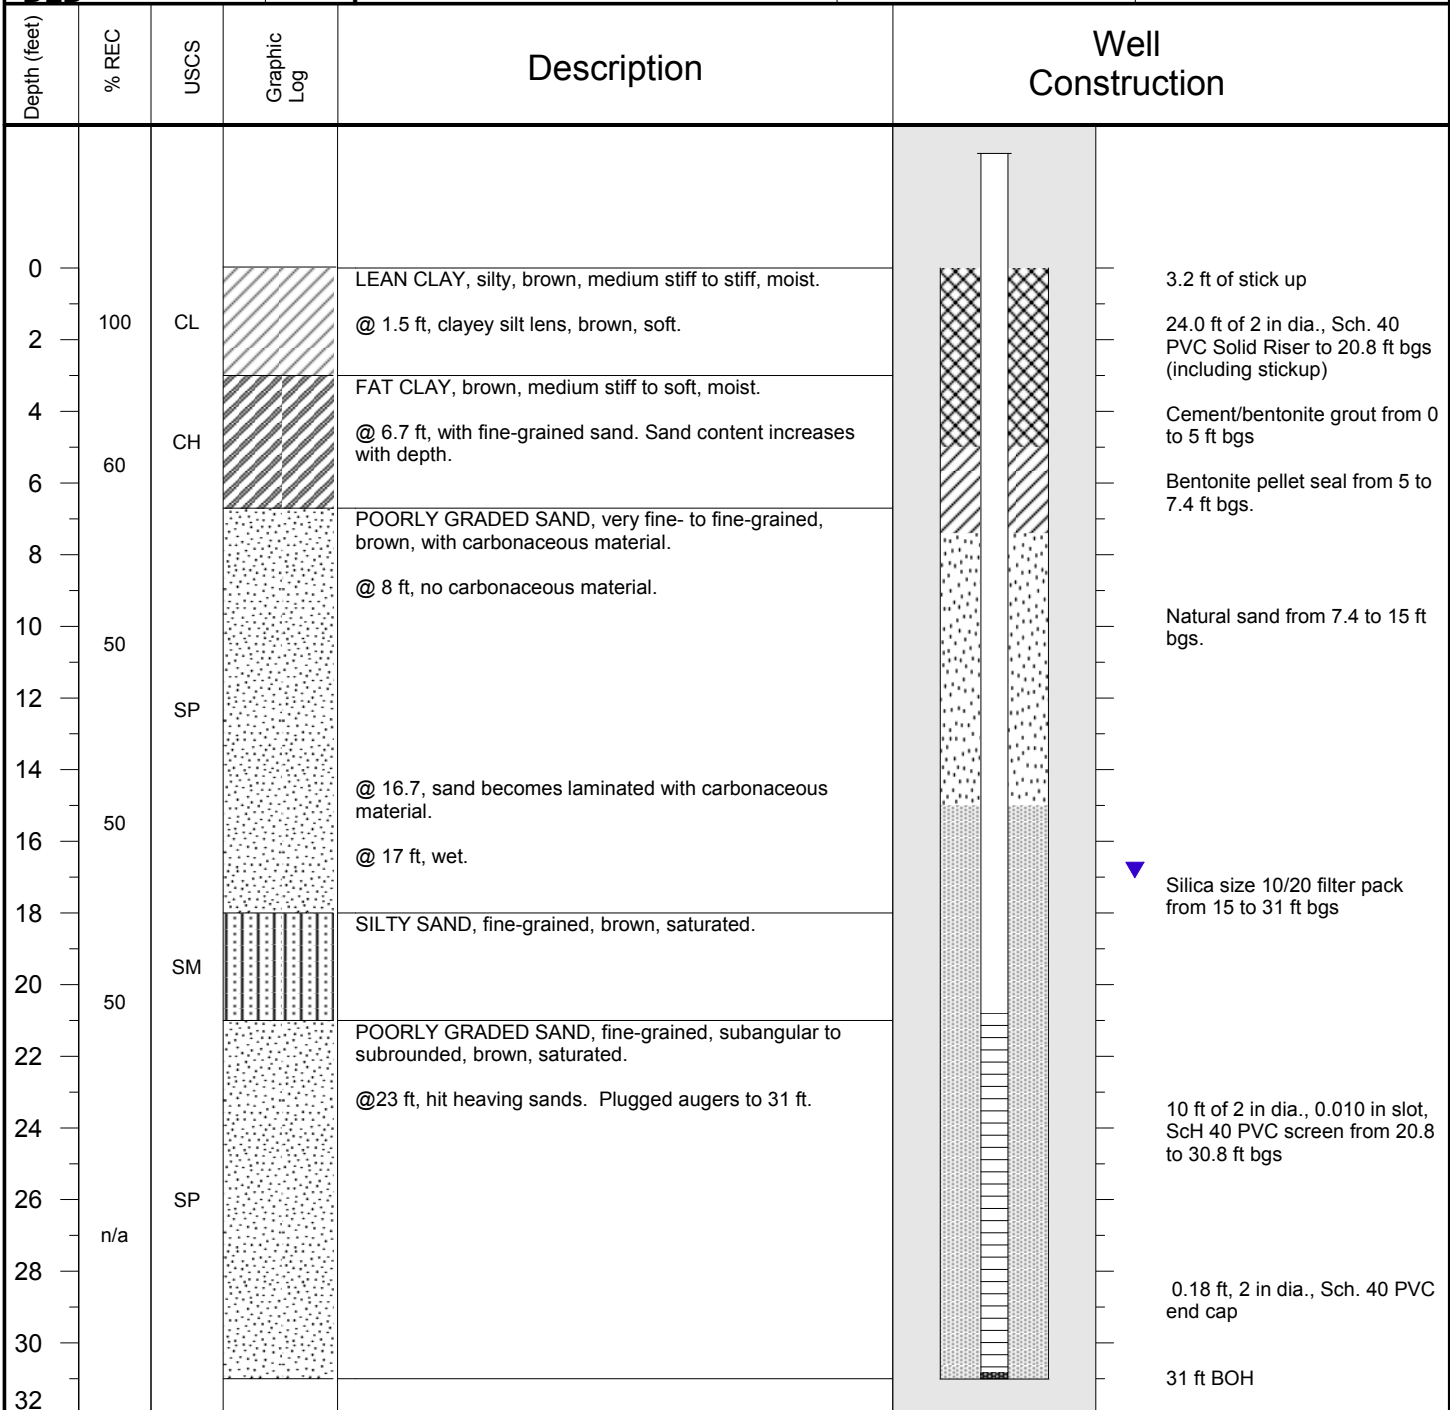

NOTES: Borehole and/or well IDs were updated to reflect the nomenclature used for the EPA CCR Rule network. Vertical and horizontal coordinates were updated based on survey report dated July 29, 2015. Horizontal and vertical coordinates are based on Arkansas State Plane NAD83 North Coordinates and NAVD88.




PROJECT: Plum Point Energy Station Landfill		BORING ID: MW-118	
LOCATION: Osceola, AR		WELL ID: MW-118	
DRILLING CONTRACTOR: McCray Drilling Inc		NORTHING: 488283.34	EASTING: 1916953.52
DRILLING EQUIPMENT: CME 750X		GROUND SURFACE ELEV.: 238.0 ft	TOC ELEVATION: 241.23 ft
DRILLING METHOD: 8.5" H.S.A.		TOTAL DEPTH: 31.4 ft below TOC	DEPTH TO WATER: 17 ft bgs
LOGGED BY: DLD	SAMPLING METHOD: 5-ft split barrel	DATE STARTED: 6/24/2015	DATE COMPLETED: 6/24/2015

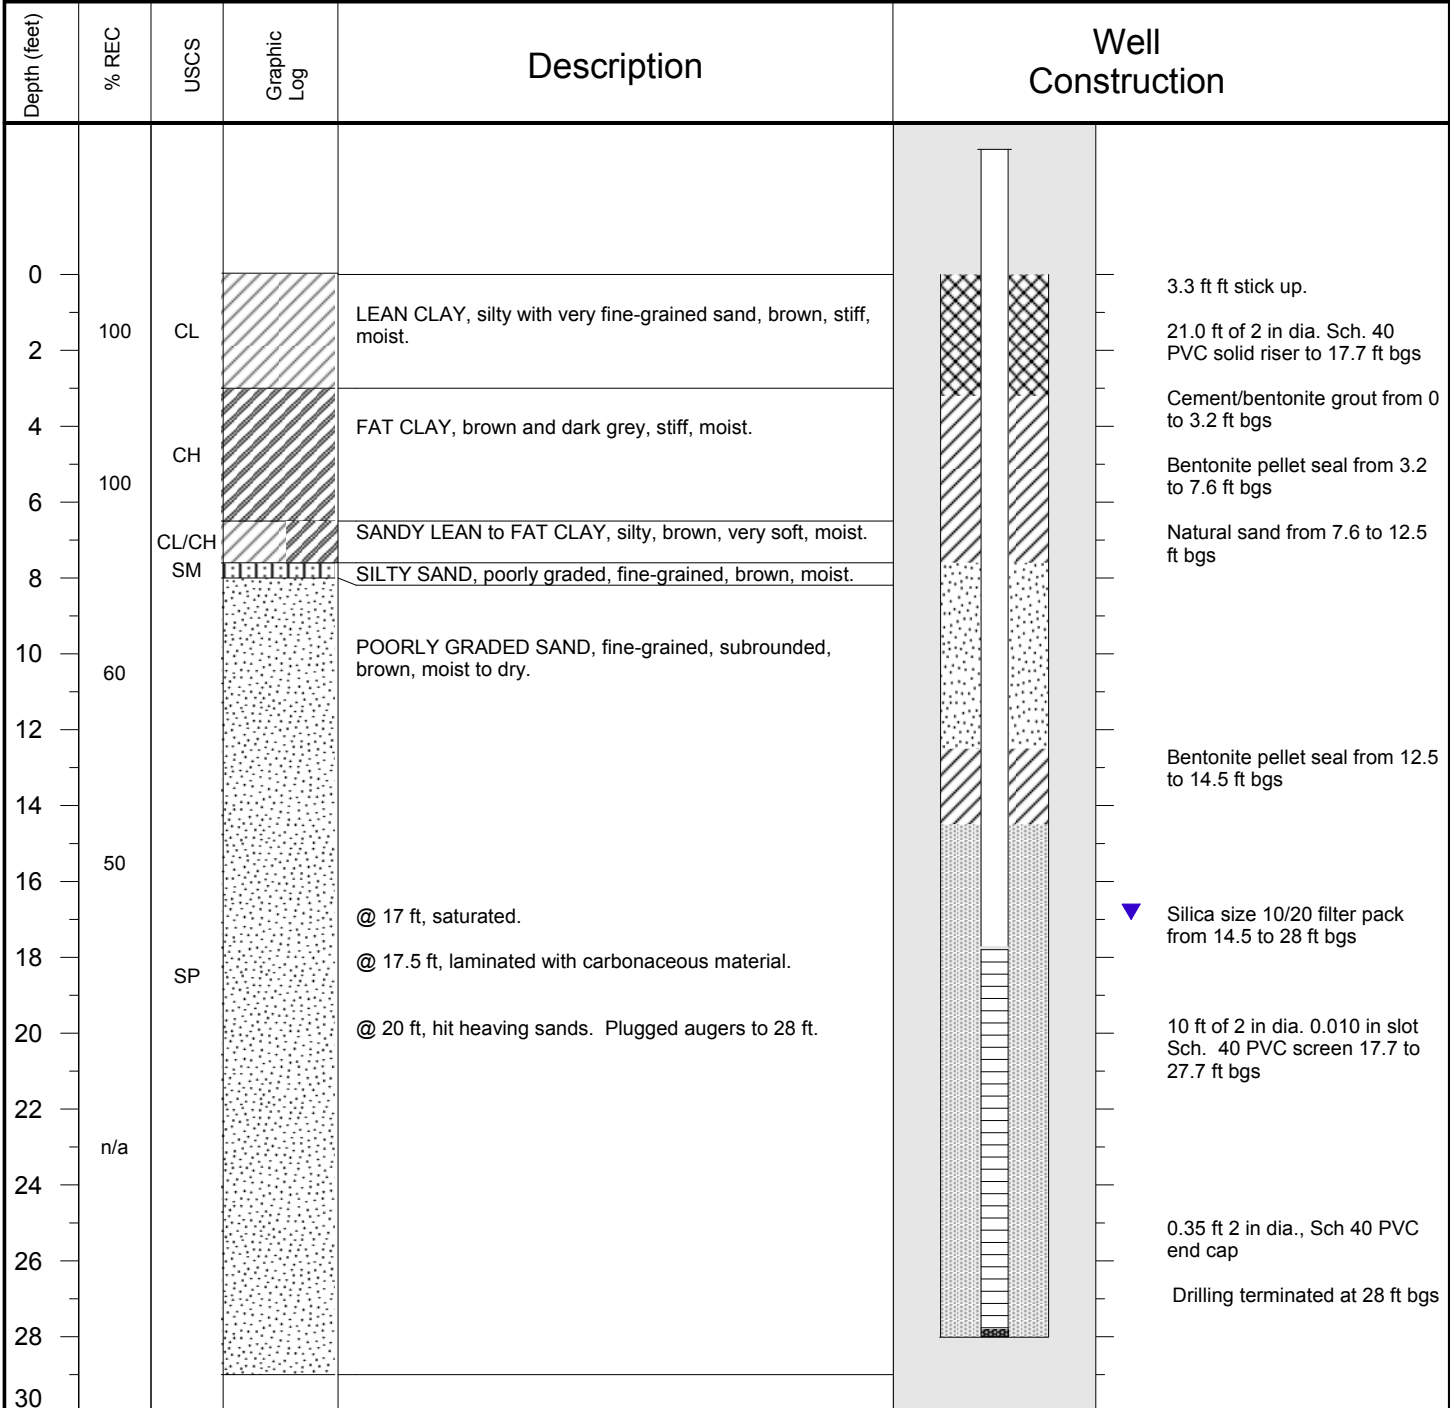

NOTES: Borehole and/or well IDs were updated to reflect the nomenclature used for the EPA CCR Rule network. Vertical and horizontal coordinates were updated based on survey report dated July 29, 2015. Horizontal and vertical coordinates are based on Arkansas State Plane NAD83 North Coordinates and NAVD88.






PROJECT: Plum Point Energy Station Landfill		BORING ID: MW-119	
LOCATION: Osceola, AR		WELL ID: MW-119	
DRILLING CONTRACTOR: McCray Drilling Inc		NORTHING: 489014.22	EASTING: 1915902.58
DRILLING EQUIPMENT: CME 750X		GROUND SURFACE ELEV.: 243.6 ft	TOC ELEVATION: 246.53
DRILLING METHOD: 8.5" H.S.A.		TOTAL WELL DEPTH: 35.4 ft bgs	DEPTH TO WATER (10/17/2016): 23.35 ft below TOC
LOGGED BY: DLD/EWS		SAMPLING METHOD: 5-ft split barrel	DATE COMPLETED: 10/6/2016
		DATE STARTED: 10/6/2016	

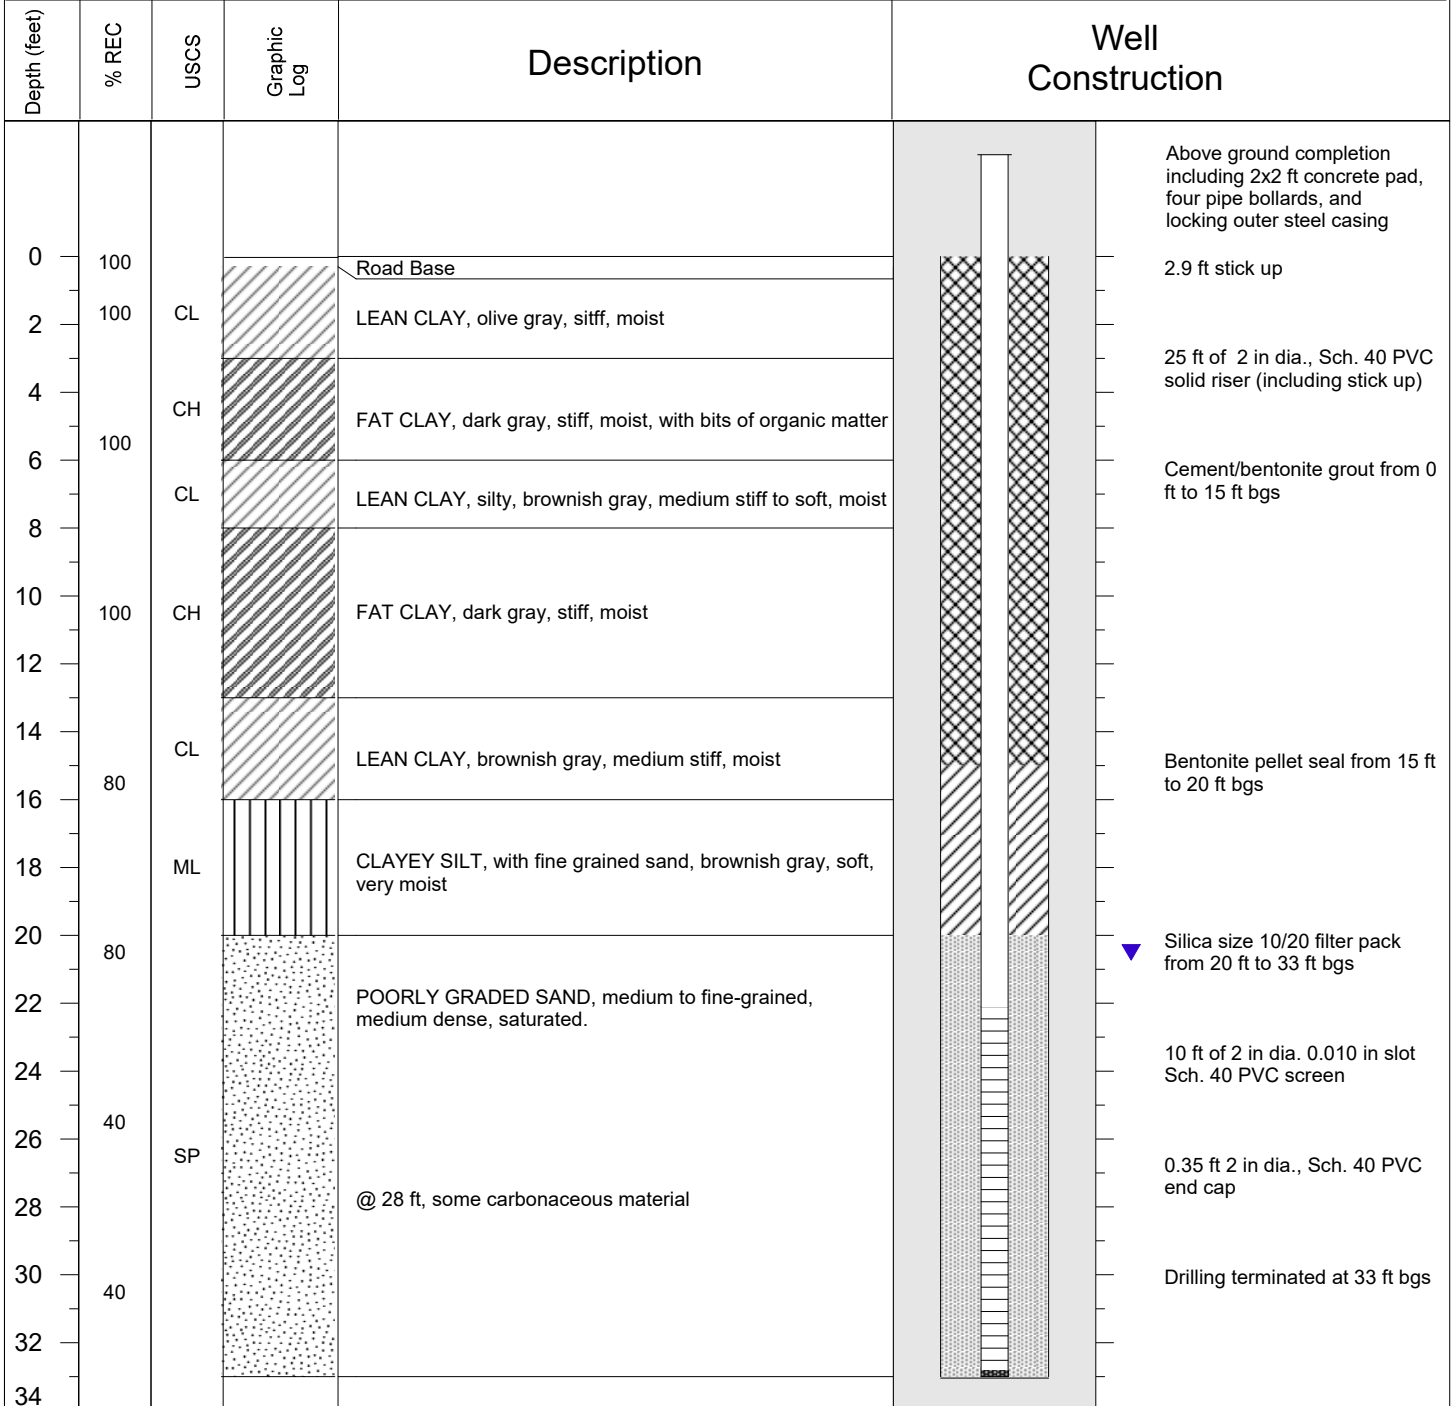

NOTES: Borehole and/or well IDs were updated to reflect the nomenclature used for the EPA CCR Rule network. Vertical and horizontal coordinates were updated based on survey report dated November 18, 2016. Horizontal and vertical coordinates are based on Arkansas State Plane NAD83 North Coordinates and NAVD88.


APPENDIX B
Geologic Cross-Sections

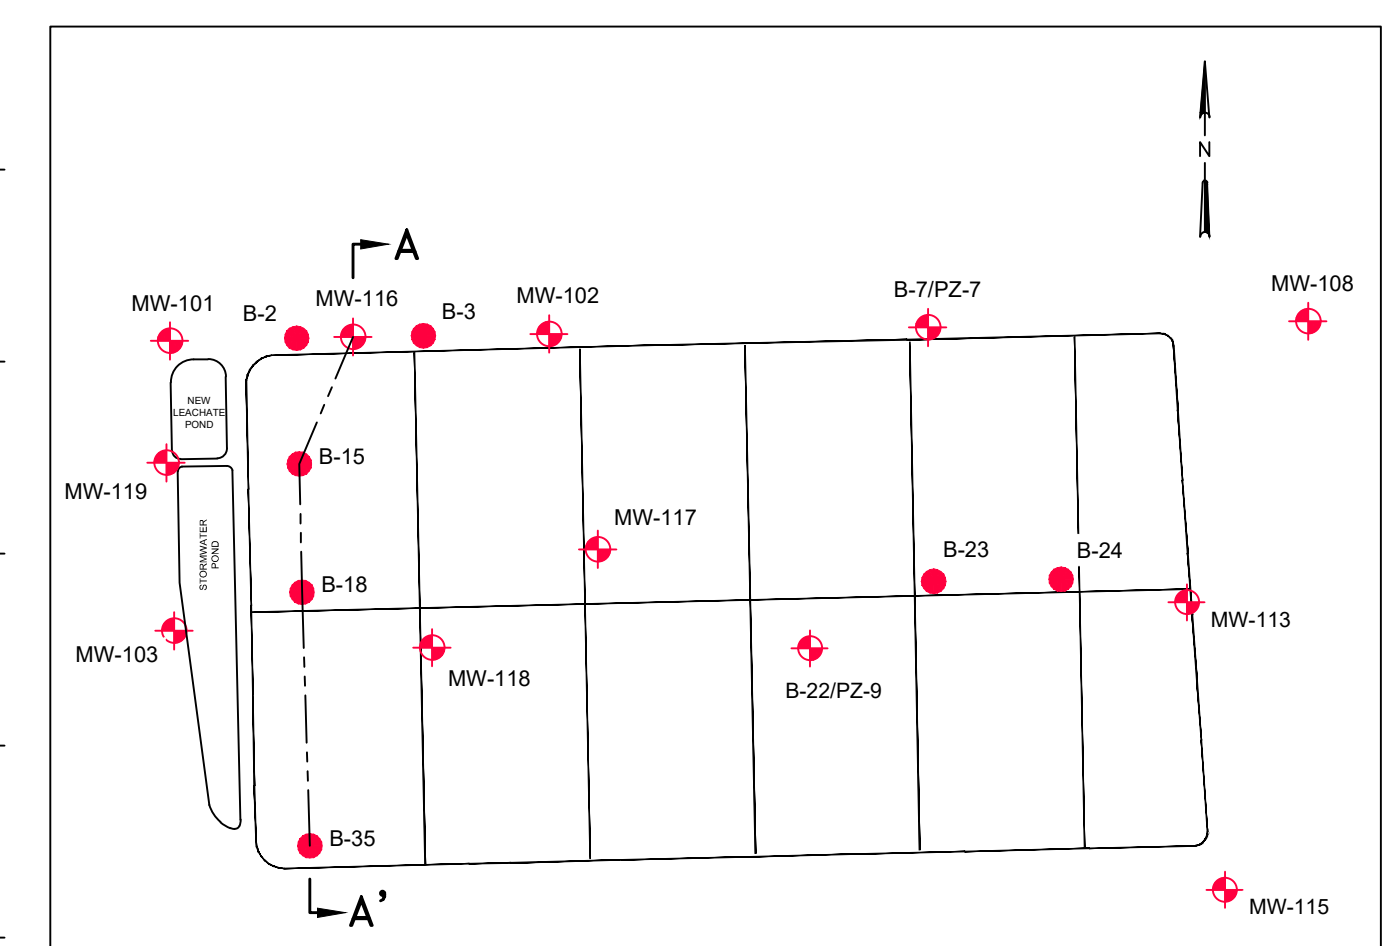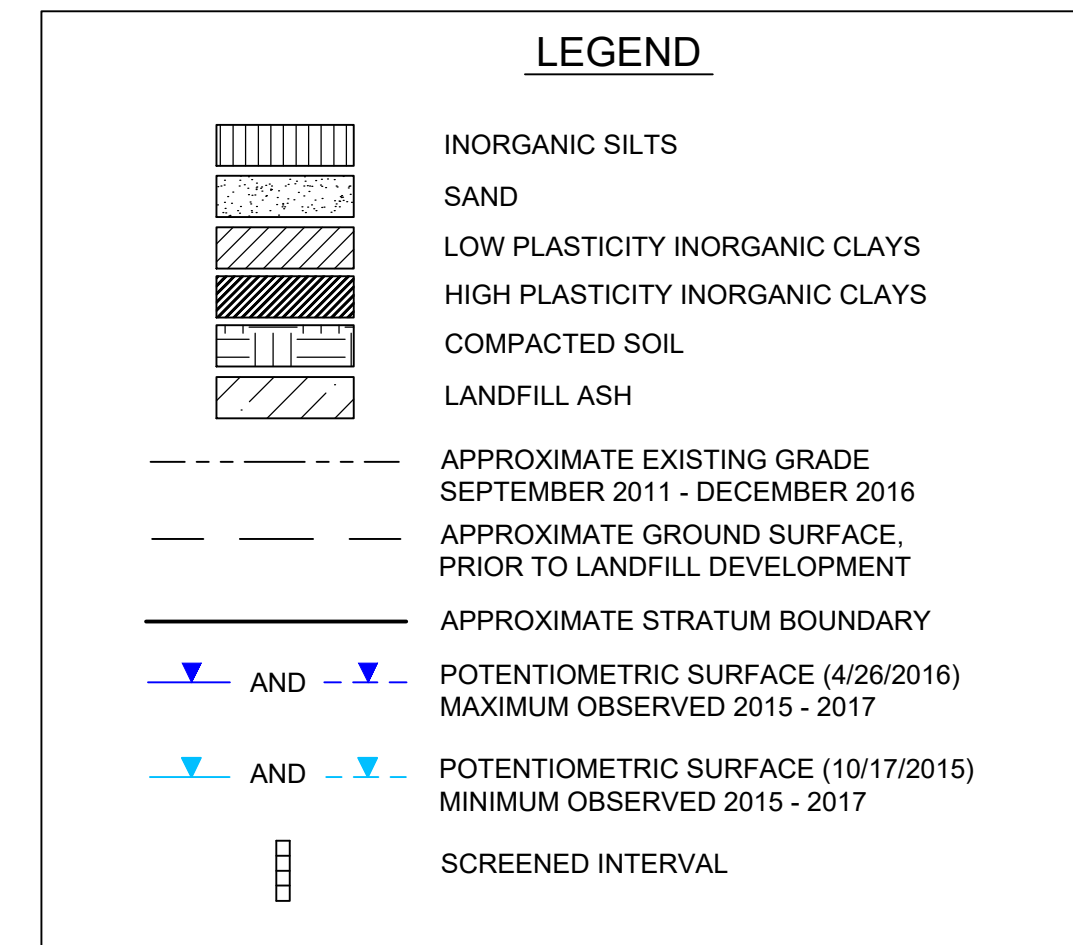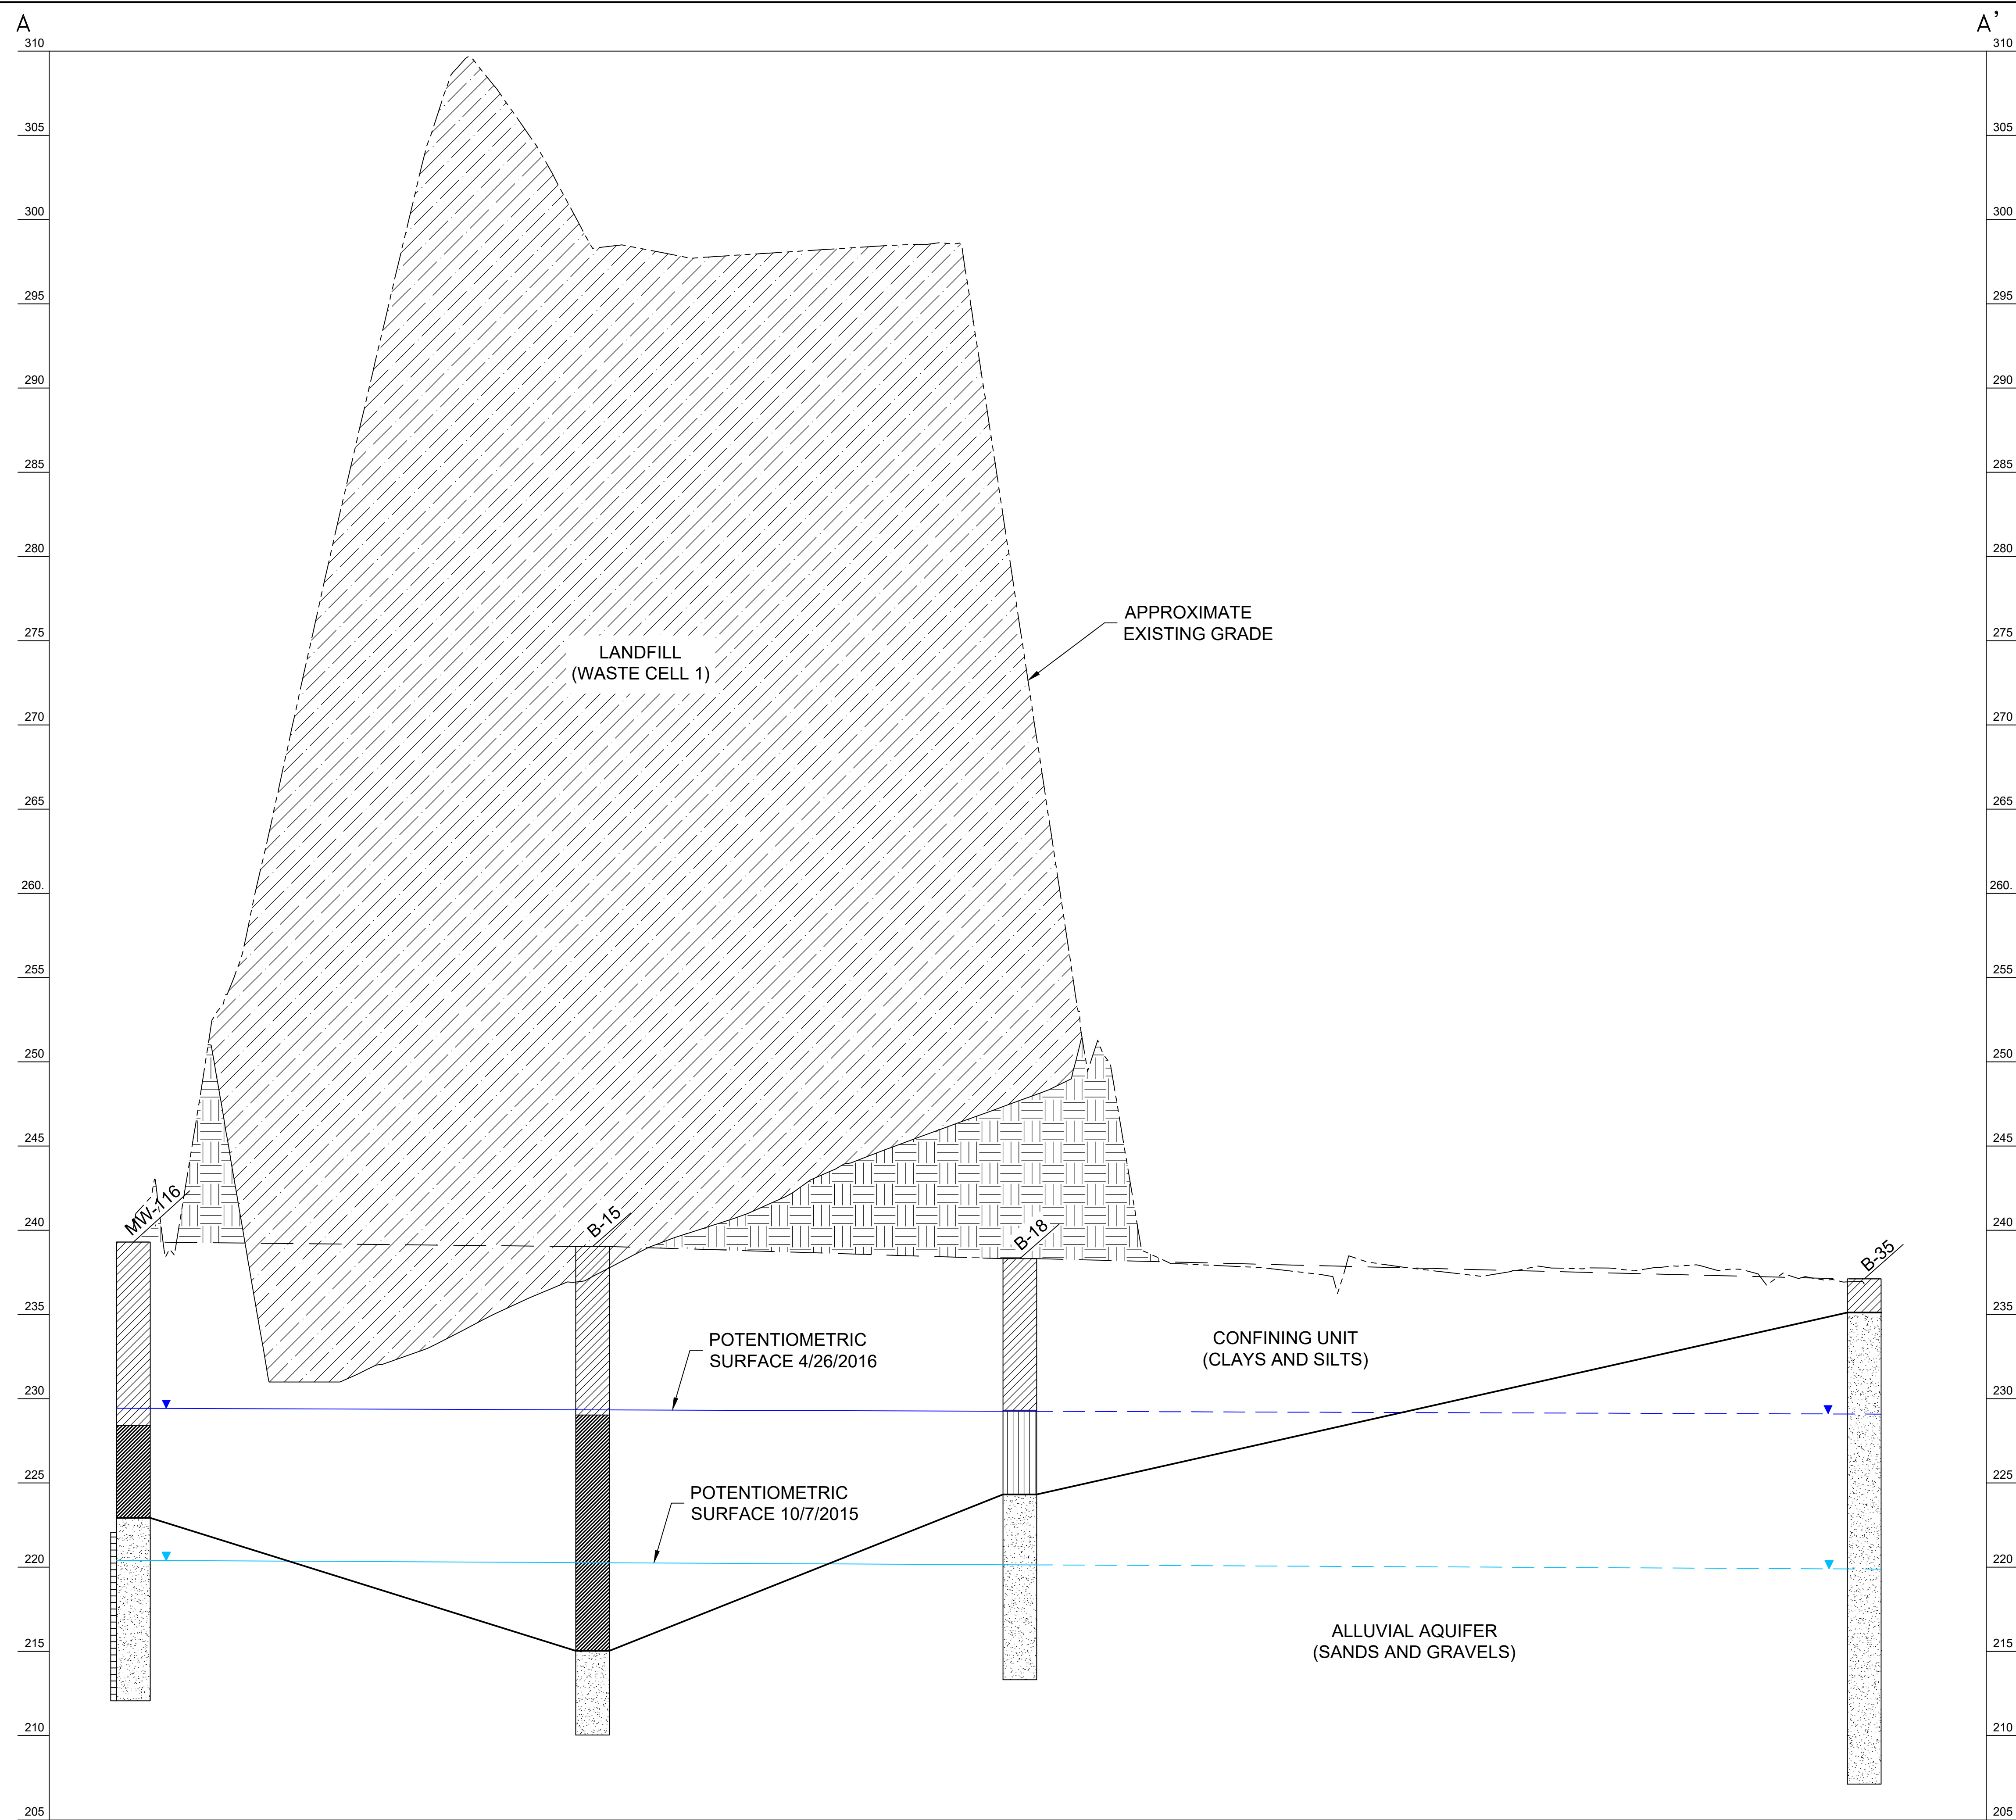


**PLUM POINT ENERGY STATION
 CCR LANDFILL
 GEOLOGIC CROSS-SECTIONS
 OSCEOLA, ARKANSAS**

**FIGURE 1
 CROSS-SECTION
 A-A'**


DRAWN BY: <i>JP</i>	FILE NAME: FG01.DWG
APPROVED: <i>AS</i>	PROJECT NO. 14590-1621-001
SCALE: AS SHOWN	DATE: 09/25/17
SHEET NO. 1	

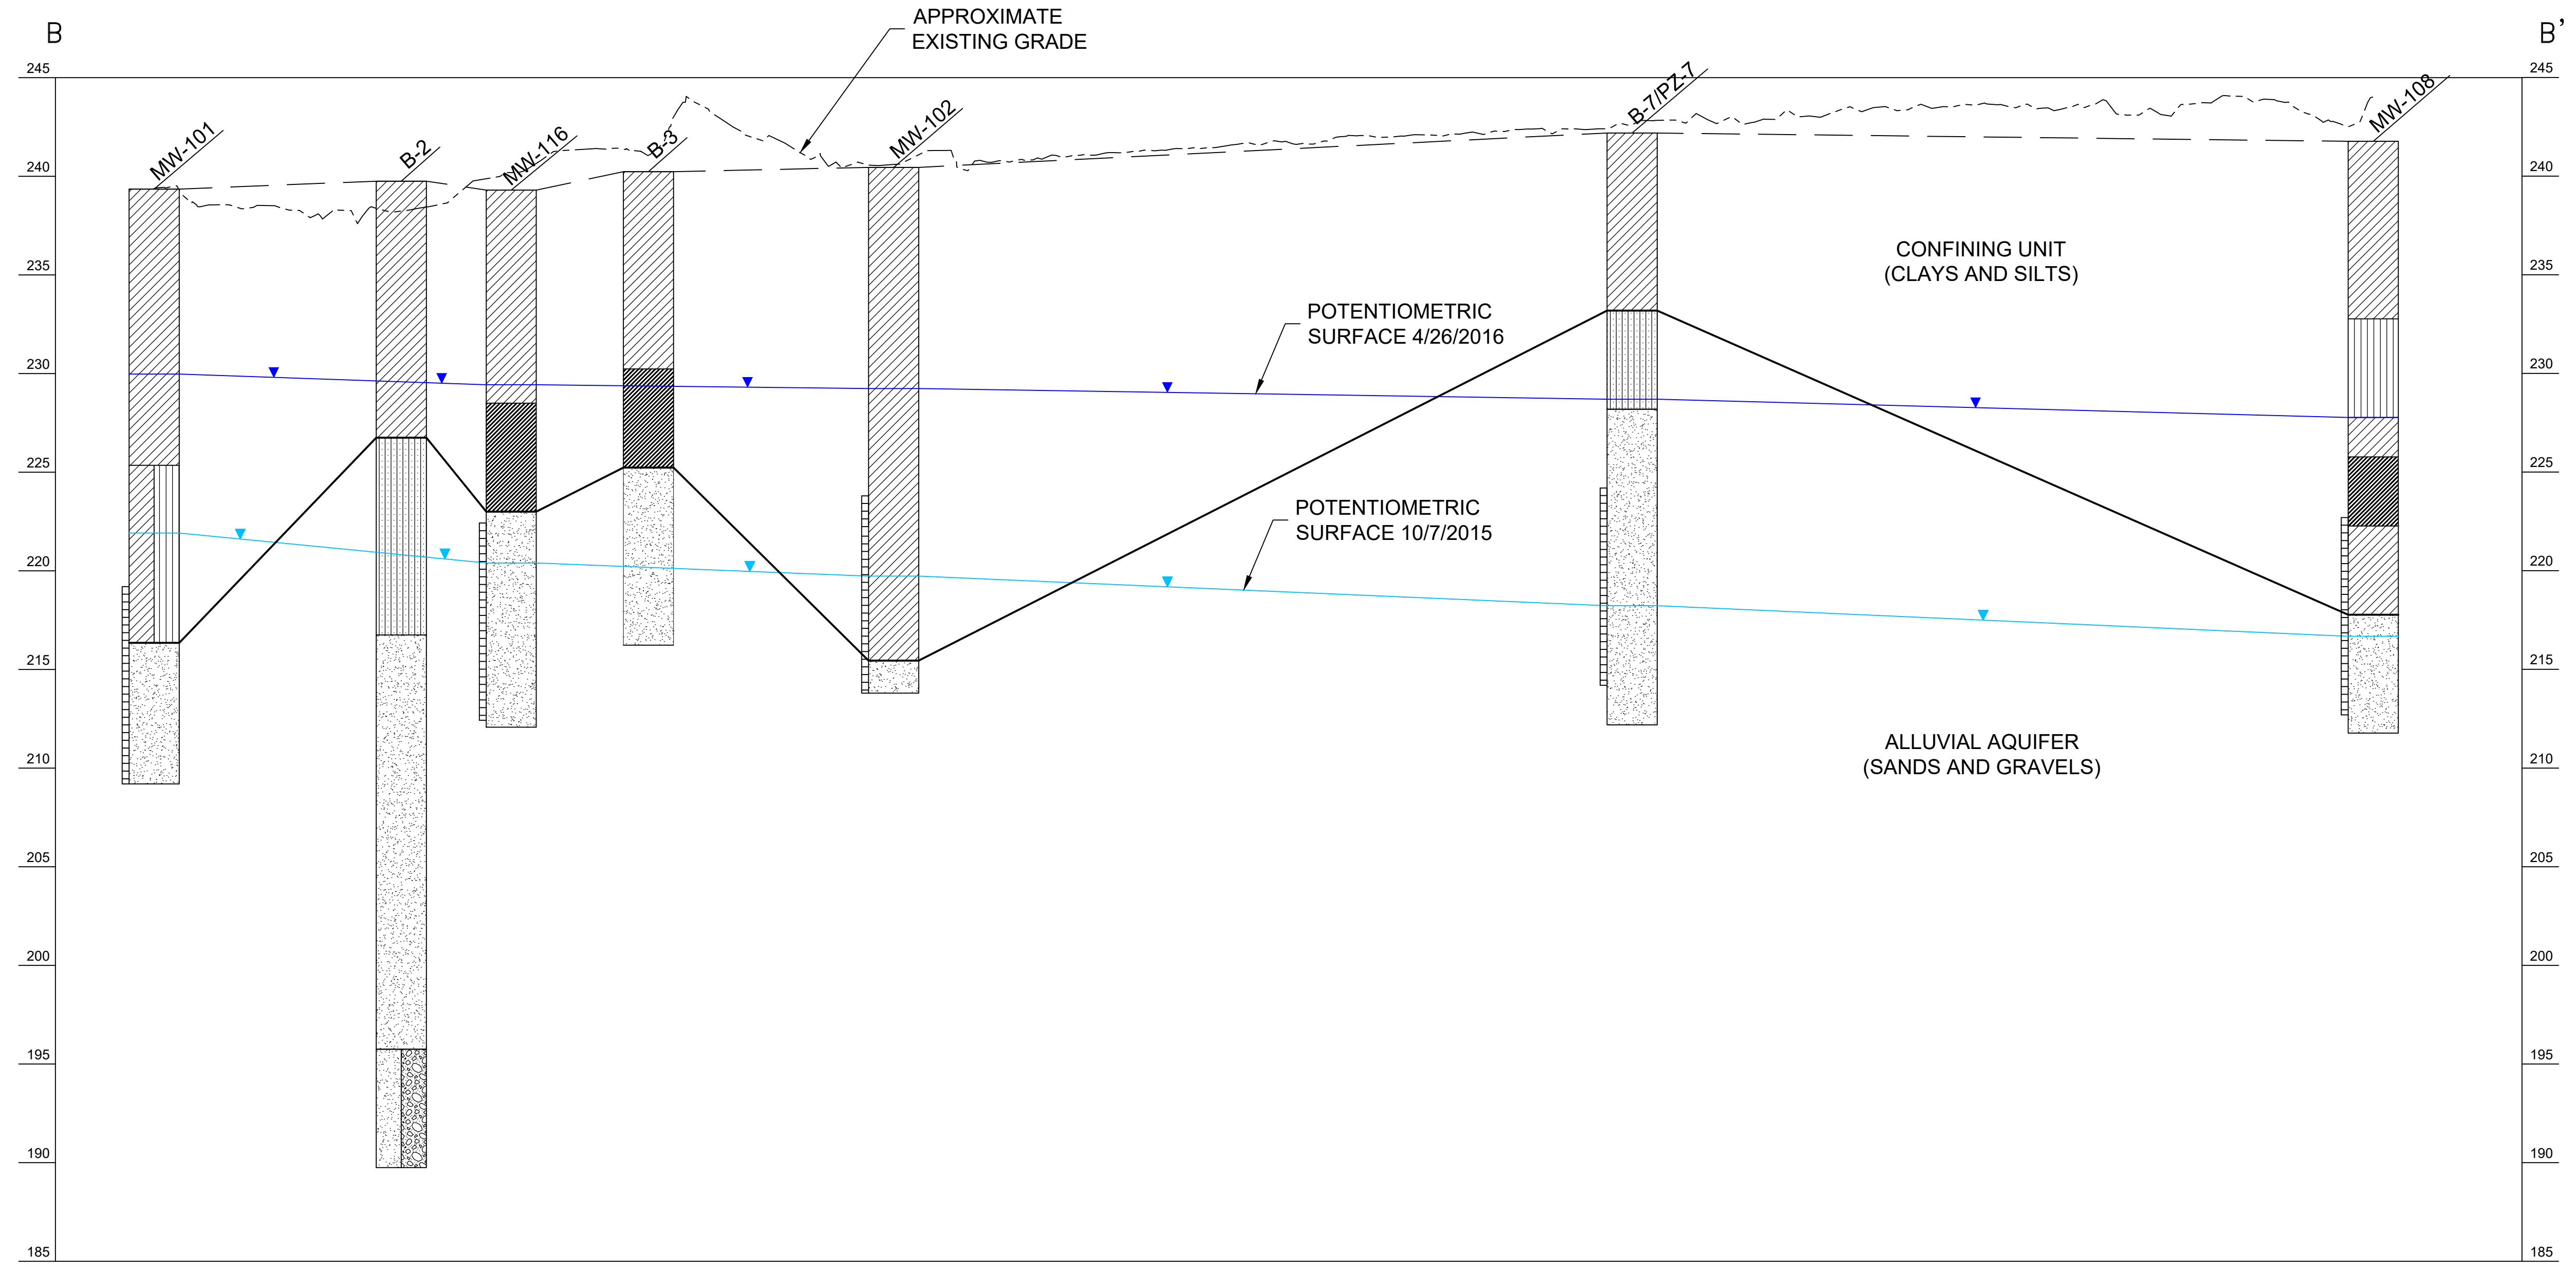

CROSS SECTION B-B'
 SCALE: 1"=200' HORIZONTAL
 SCALE: 1"=5' HORIZONTAL
 VERTICAL EXAGGERATION = 40X

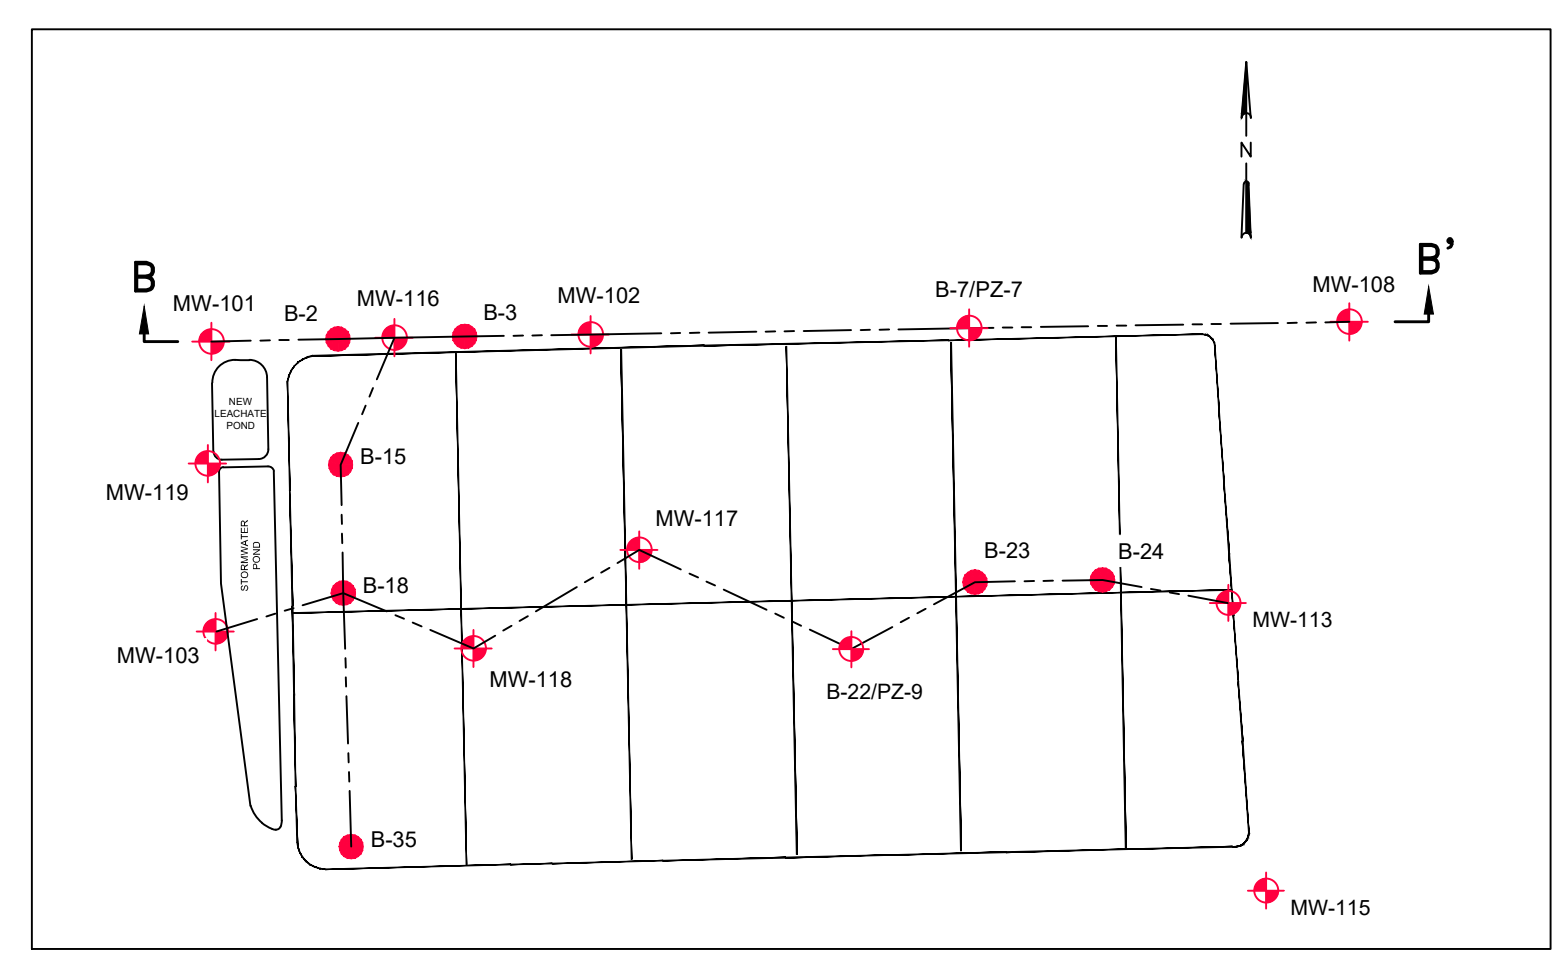


**CROSS SECTION
 REFERENCE LOCATION**

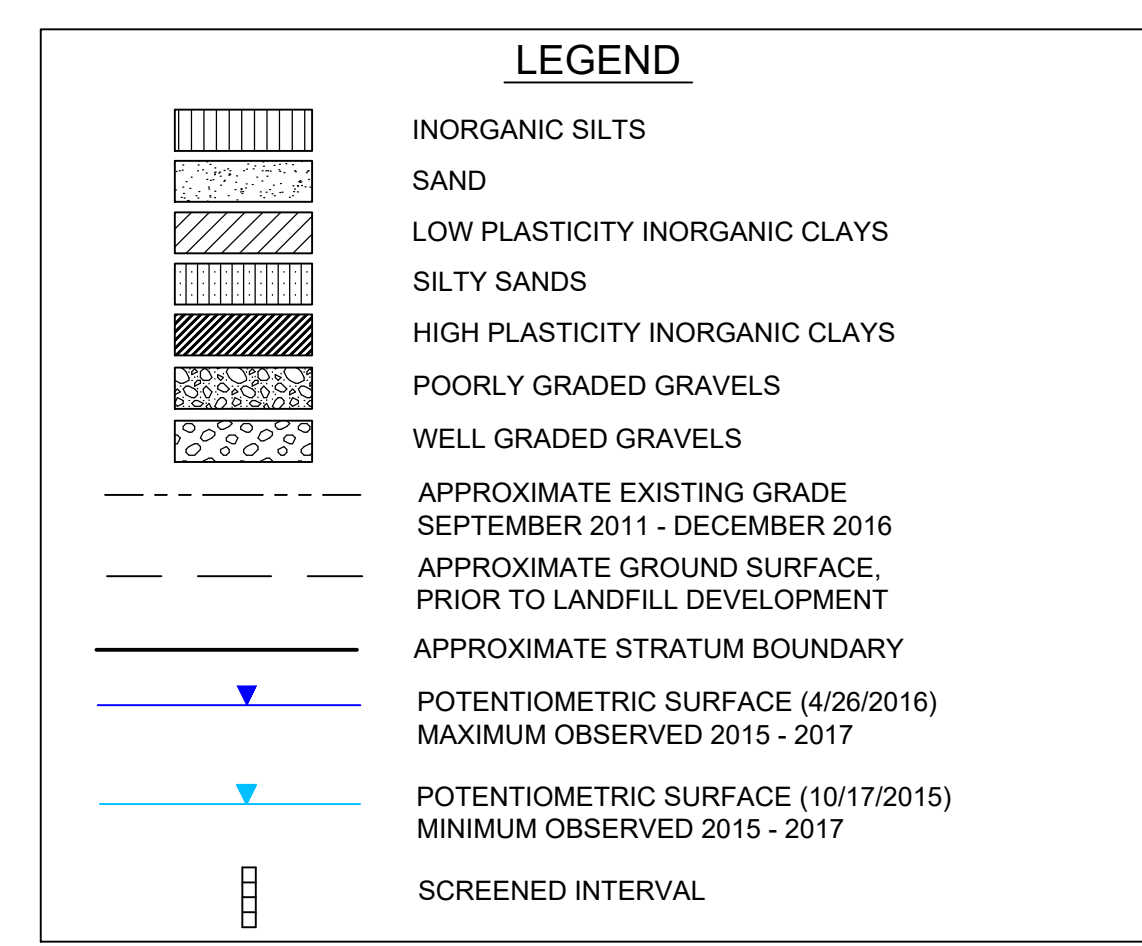

**PLUM POINT ENERGY STATION
 CCR LANDFILL
 GEOLOGIC CROSS-SECTIONS
 OSCEOLA, ARKANSAS**


**FIGURE 2
 CROSS-SECTION
 B-B'**

DRAWN BY: J.P.	FILE NAME: FG02.DWG
APPROVED: A.P.	PROJECT NO. 14590-1621-001
SCALE: AS SHOWN	DATE: 09/25/17
SHEET NO.	1

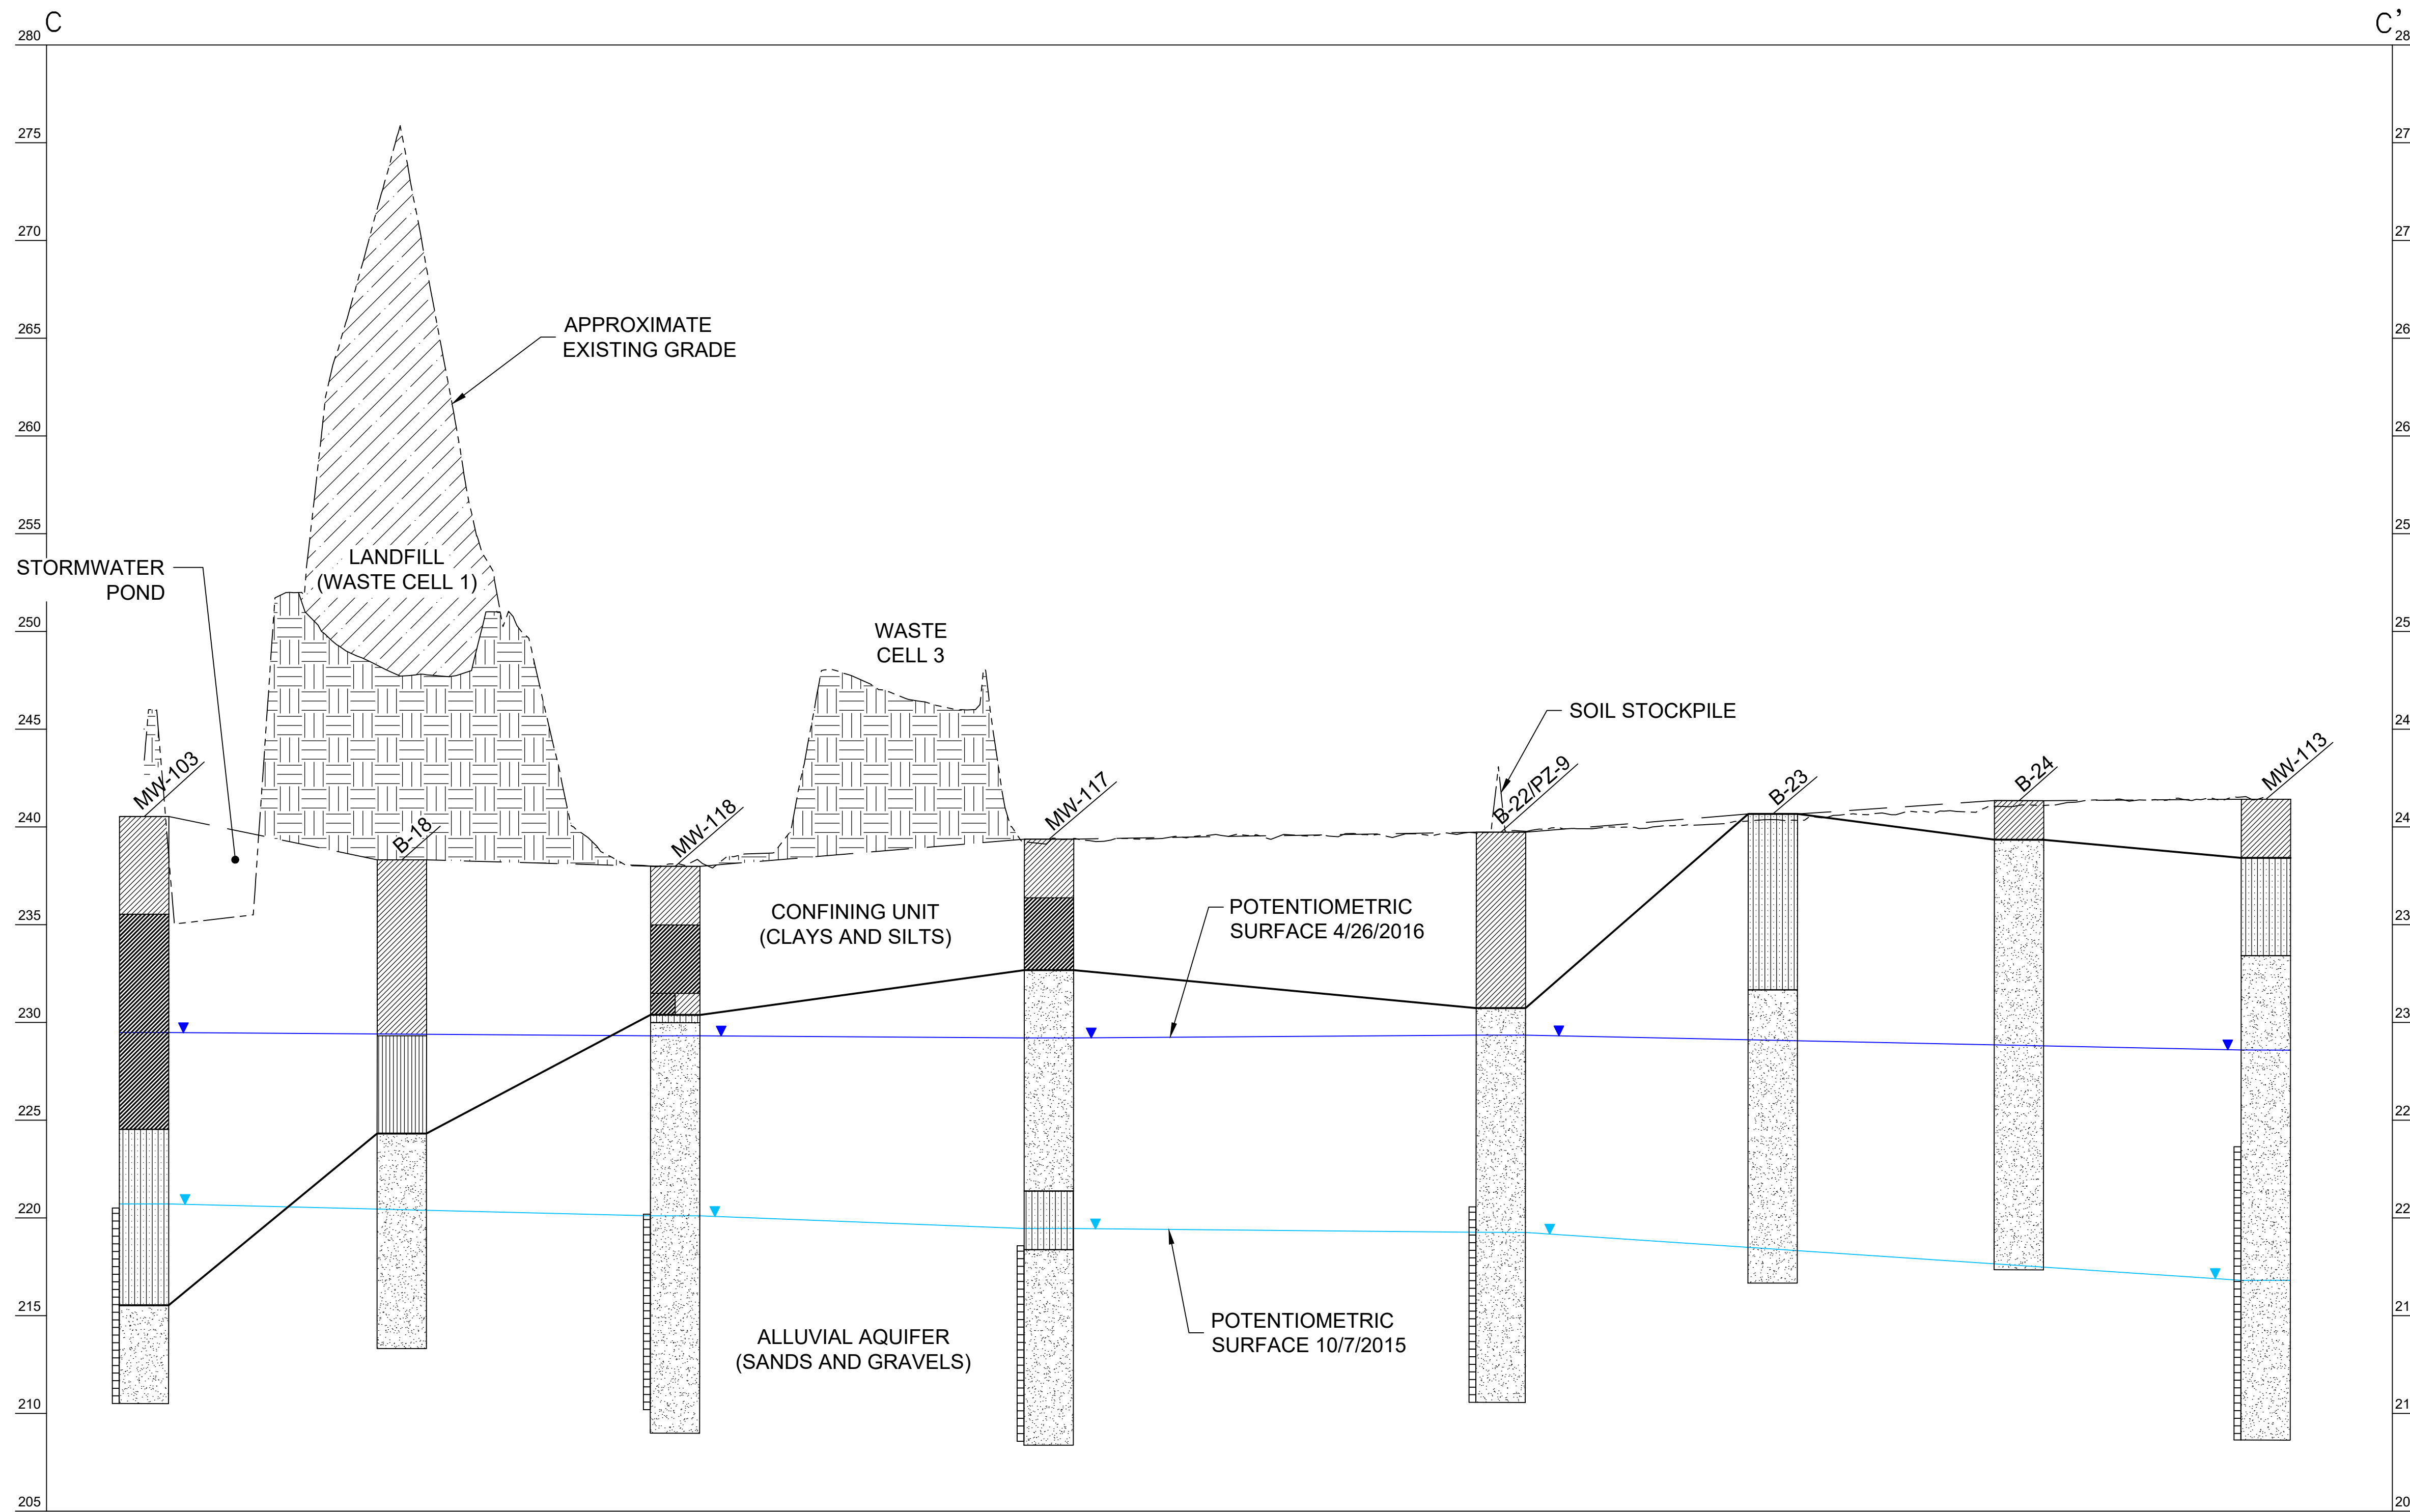

CROSS SECTION C-C'

SCALE: 1"=200' HORIZONTAL
 SCALE: 1"=5' HORIZONTAL
 VERTICAL EXAGGERATION = 40X

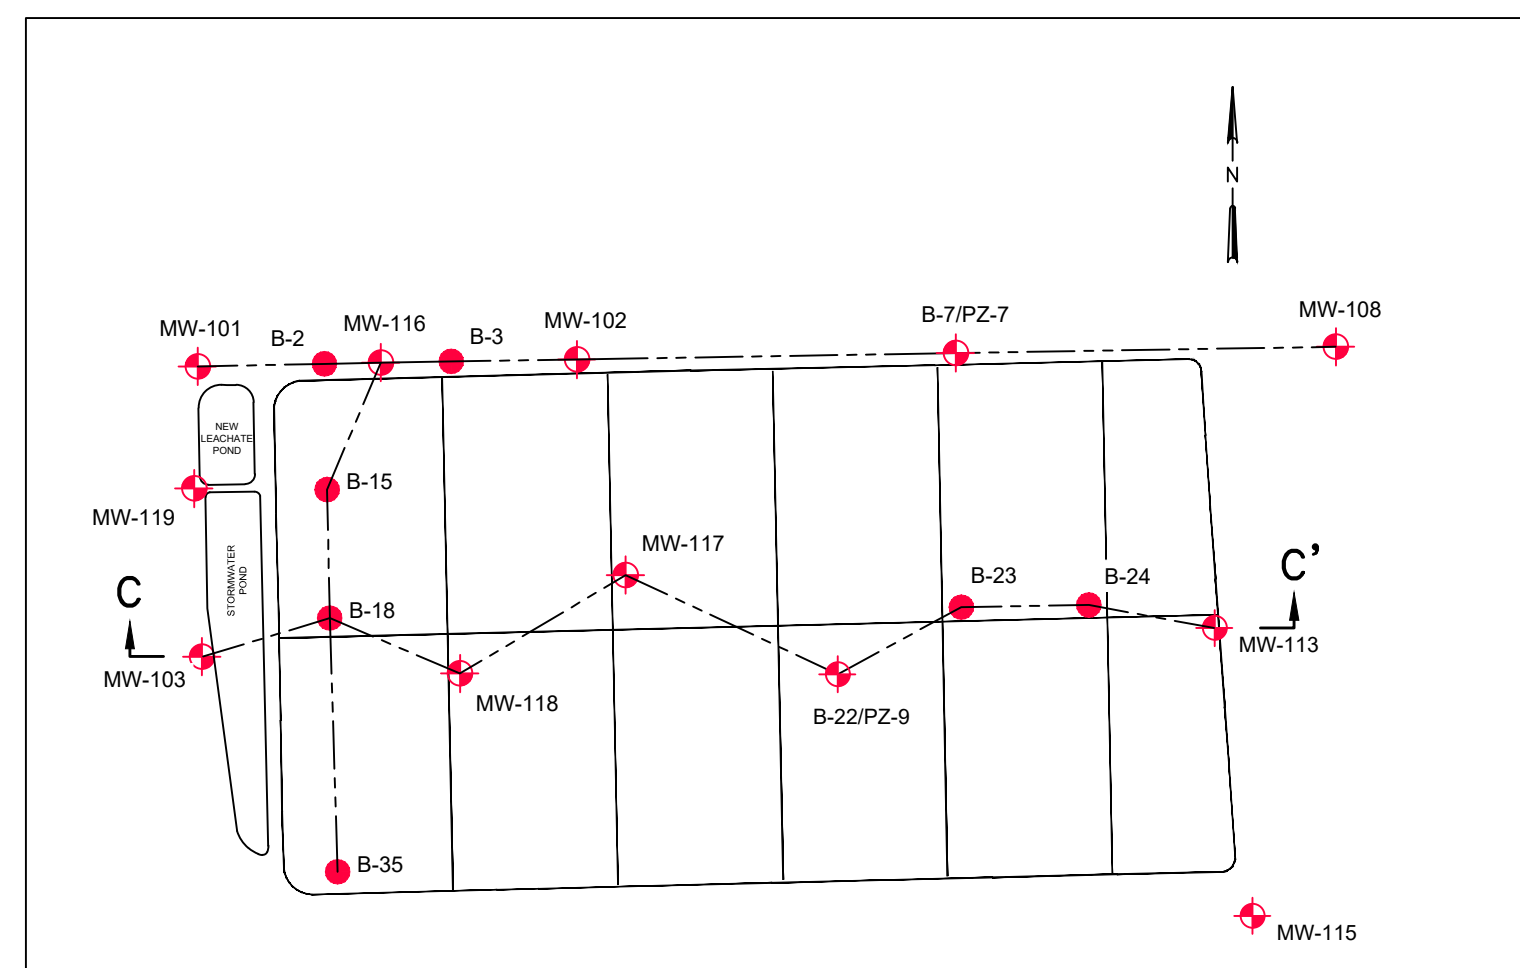

**CROSS SECTION
 REFERENCE LOCATION**

LEGEND	
	INORGANIC SILTS
	SAND
	LOW PLASTICITY INORGANIC CLAYS
	SILTY SANDS
	HIGH PLASTICITY INORGANIC CLAYS
	WELL GRADED GRAVELS
	COMPACTED SOIL
	LANDFILL ASH
	APPROXIMATE EXISTING GRADE SEPTEMBER 2011 - DECEMBER 2016
	APPROXIMATE GROUND SURFACE, PRIOR TO LANDFILL DEVELOPMENT
	APPROXIMATE STRATIUM BOUNDARY
	POTENTIOMETRIC SURFACE (4/26/2016) MAXIMUM OBSERVED 2015 - 2017
	POTENTIOMETRIC SURFACE (10/7/2015) MINIMUM OBSERVED 2015 - 2017
	SCREENED INTERVAL

**PLUM POINT ENERGY STATION
 CCR LANDFILL
 GEOLOGIC CROSS-SECTIONS**

OSCEOLA, ARKANSAS

**FIGURE 3
 CROSS-SECTION
 C-C'**

DRAWN BY:	FILE NAME:
APPROVED:	PROJECT NO.
SCALE:	DATE:
SHEET SHOWN	09/14/17
SHEET NO.	1